

**MISSISSIPPI DEPARTMENT OF ENVIRONMENTAL QUALITY**  
Bureau of Land and Water Resources

2520

P. O. Box 10631  
Jackson, MS 39289-0631  
WATER WELL DRILLERS LOG

COUNTY WELL LOCATED <b>SMITH</b>	
WELL NUMBER <b>H 20</b>	CODED <input checked="" type="checkbox"/>
DATE WELL COMPLETED <b>7-23-92</b>	

PERMIT NUMBER
NAME OF DRILLING FIRM <b>PARKER WELL SERVICE</b>

NAME & MAILING ADDRESS OF LANDOWNER <b>William Wedgeworth</b> <b>RT. LOUIN MISS</b>		
WELL LOCATION: SEC	TOWNSHIP	RANGE
<b>8</b>	<b>3</b>	<b>N 09 E</b>
DISTANCE	DIRECTION	NEAREST TOWN
<b>2</b> Miles	<b>South</b>	<b>Pineville</b>
OTHER LANDMARK <b>501 Pineville Smith Co.</b>		
WELL PURPOSE: Home, Irrigation, Municipal, Industrial, Fish Pond, etc. <b>Chicken Houses</b>		

<b>PUMP DATA</b>		
PUMP TYPE (Circle One): <input checked="" type="checkbox"/> Submersible, Turbine, Jet, Flowing Well, Other (Describe) _____		
POWER TYPE (Circle One): <input checked="" type="checkbox"/> Electric, Tractor, Diesel, Gasoline, Butane, Other (Describe) _____ H/P <b>2</b>		
Pump Capacity (GPM)	No. of Stages	Setting Depth
<b>35</b>	<b>12</b>	<b>252 FT.</b>
<b>PUMP TEST</b>		
Well yielded <b>30</b> GPM with a drawdown of <b>50</b> ft. after <b>24</b> hours of pumping		

<b>WELL DATA</b>		
Well Depth	Casing Diameter (in.)	Casing Length (Ft.)
<b>555</b>	<b>4"</b>	<b>500</b>
Type of Casing	Hole Depth	Depth to Static Water Level
<b>PVC</b>	<b>555</b>	<b>95'</b>
TYPE OF COMPLETION: (Circle One or More): <input checked="" type="checkbox"/> Gravel Packed, Underreamed, <input checked="" type="checkbox"/> Telescoped, <input type="checkbox"/> Natural Development, <input type="checkbox"/> Open Hole, <input type="checkbox"/> Other		
Top of Lap Pipe or Reduction in Casing		
FEET <input type="checkbox"/> IF TELESCOPED OR MORE THAN ONE SCREEN: USE BACK PAGE		

<b>LOG DATA</b>	
TYPE OF LOG RUN (Circle One): <input type="checkbox"/> No Log Run, Electric, Gamma Ray, Density, Sonic, Neutron, Other (Describe) _____	
Name of Organization Running Log	

<b>SCREEN DATA</b>		
Diameter - Inches	Length - Feet	Slot Size - Inches
<b>2"</b>	<b>20'</b>	<b>008</b>
Screen Type	Depth to Bottom - Feet	
<b>PVC</b>	<b>555</b>	


<b>GEOLOGIC DATA (Office Use Only)</b>			
Surface Elev.	Geologic Unit	Unit Thickness	Depth to Top
Subs. SWL	Date	Analysis	Aquifer Test
Driller's Remarks <b>GO TO COARSE SAND PLENTY OF WATER</b>			

DESCRIPTION OF FORMATIONS ENCOUNTERED	FROM	TO
<b>CLAY &amp; SAND</b>	<b>0</b>	<b>25</b>
<b>Gumbo</b>	<b>25</b>	<b>400</b>
<b>STRIPS LIMEROCK</b>	<b>400</b>	<b>415</b>
<b>GUMBO &amp; SAND</b>	<b>415</b>	<b>470</b>
<b>FINE SAND</b>	<b>470</b>	<b>520</b>
<b>COARSE SAND</b>	<b>520</b>	<b>555</b>

FORMATIONS (Continued)	FROM	TO
<b>RECEIVED</b>		
<b>JUL 29 1992</b>		
<b>Dept. of Environmental Quality</b> <b>Bureau of Land &amp; Water Resources</b>		
IF MORE SPACE IS NEEDED, USE BACK		


If well telescopes please sketch and show depths.

GROUND LEVEL

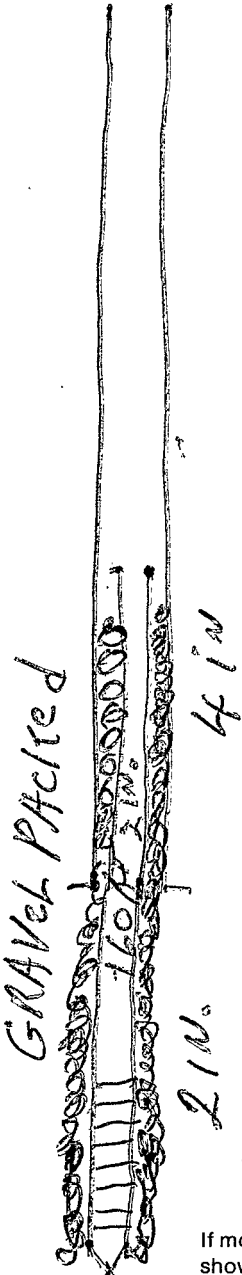

If more than one screen, show location of each on sketch.

R9E

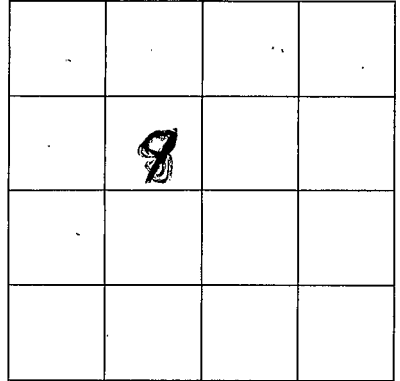

SECTION 8

Please indicate well location X.

ADDITIONAL INFORMATION

GO EAST RALEIGH  
ON HW. 18 TO HW. 501  
TAKE LEFT GO  
APP. 10 MI. GO DOWN  
IN Hollow W  
CHICKEN HOUSES  
TO RIGHT

