

Smith
H 2000
1-17-76

MISSISSIPPI
 BOARD OF WATER COMMISSIONERS
 416 North State Street
 Jackson, Mississippi 39201

13¢

WATER WELL DRILLERS LOG

Jan-17 1976 RR Wilkerson Drill. Co Smith
 date well completed firm name county well located

LANDOWNER: Lavelle Wedgworth
P.O. Box 157
Mc. Cordsville, Ind. 46055
 (mailing address)


description of formations encountered	from	to
<u>yellow clay</u>	<u>0</u>	<u>50</u>
<u>Blue clay</u>	<u>50</u>	<u>430</u>
<u>Water B. Sand</u>	<u>430</u>	<u>462</u>

WELL LOCATION:
 sec. 2 T. 3 N. R. 9 E.
5 miles E. of Pineville
 (distance) (direction) (nearest town)

WELL PURPOSE: Home
 (home, irrigation, municipal, industrial)

WELL COMPLETION DATA:

- (1) diameter (inches) 7"
- (2) total depth (feet) 462
- (3) static water level (feet) 90' below above top of ground.
- (4) casing galv.
 (material) (depth)
 (size) If telescope see back.
- (5) screen 5'
 (length) (depth to top)
2" 8 Steel
 (size) (material)
- (6) pump 1 1200 gph
 (HP) (yield gpm)
elec
 (type power)
- (7) electric log no
 (yes or no)
 (organization running log)
- (8) how well bottom plugged Bill 1/2

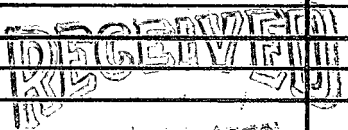


JAN 28 1976

DRILLERS REMARKS:

If well telescopes please sketch and show depths.

GROUND LEVEL

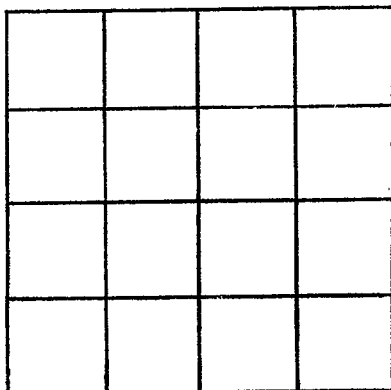

SECTION _____

Please indicate well location X.

ADDITIONAL INFORMATION

Lined area for providing additional information, consisting of 20 horizontal lines.

If more than one screen, show locations of each on sketch.