

MISSISSIPPI DEPARTMENT OF ENVIRONMENTAL QUALITY
Bureau of Land and Water Resources

P. O. Box 10631
Jackson, MS 39299-0631
WATER WELL DRILLERS LOG

COUNTY WELL LOCATED SMITH	
WELL NUMBER H 2001	CODES
DATE WELL COMPLETED 2-12-93	

PERMIT NUMBER
NAME OF DRILLING FIRM PARKER WELL Service

NAME & MAILING ADDRESS OF LANDOWNER JIMMY GRAYSON LOUIN MISS.			
WELL LOCATION:	SEC	TOWNSHIP	RANGE
	1	T3	(N) S R9 (E) W
DISTANCE	DIRECTION	NEAREST TOWN	
6 Miles	WEST	LOUIN	
OTHER LANDMARK GREEN TREE LAKE			
WELL PURPOSE: Home, Irrigation, Municipal, Industrial, Fish Pond, etc. Chicken Houses			

PUMP DATA		
PUMP TYPE (Circle One): <input checked="" type="radio"/> Submersible Turbine, Jet Flowing Well, Other (Describe) _____		
POWER TYPE (Circle One): Electric, Tractor, Diesel, Gasoline, Butane, Other (Describe) _____ H/P 15		
Pump Capacity (GPM)	No. of Stages	Setting Depth
20	9	160 FT.
PUMP TEST		
Well yielded 26 GPM with a drawdown of 40 ft. after 6 hours of pumping		

WELL DATA		
Well Depth 480	Casing Diameter (In.) 4"	Casing Length (Ft.) 460
Type of Casing PVC	Hole Depth 480	Depth to Static Water Level 60'
TYPE OF COMPLETION: (Circle One or More): <input checked="" type="radio"/> Gravel Packed, Underreamed, Telescoped, Natural Development, Open Hole, Other (Describe) _____		
Top of Lap Pipe or Reduction in Casing		
FEET IF TELESCOPED OR MORE THAN ONE SCREEN: USE BACK PAGE		

LOG DATA	
TYPE OF LOG RUN (Circle One): No Log Run, Electric, Gamma Ray, Density, Sonic, Neutron, Other (Describe) _____	
Name of Organization Running Log	

SCREEN DATA		
Diameter - Inches 4"	Length - Feet 20'	Slot Size - Inches 006
Screen Type PVC	Depth to Bottom - Feet 480	

GEOLOGIC DATA (Office Use Only)			
Surface Elev.	Geologic Unit	Unit Thickness	Depth to Top
Subs. SWL	Date	Analysis	Aquifer Test

Driller's Remarks SAND FINE AT 420 TO 440 CORSE 440 TO 480 GOOD WELL
--


DESCRIPTION OF FORMATIONS ENCOUNTERED	FROM	TO
Yellow clay	0	20
Gumbo	20	420
SAND	420	480

FORMATIONS (Continued)	FROM	TO
RECEIVED		
FEB 23 1993		
Part. of Environmental Quality Office of Land & Water Resources		
IF MORE SPACE IS NEEDED, USE BACK		

If well telescopes please sketch and show depths.

GROUND LEVEL

R9W

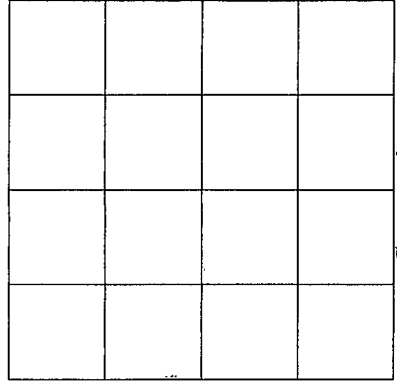

SECTION 1

Please indicate well location X.

ADDITIONAL INFORMATION

GO TO PINEVILLE IN
SMITH CO. ON 501
TAKE RIGHT 6 MILES
TO CROSS ROADS
TAKE RIGHT GO TO
END BLACK TOP
ROAD TAKE LEFT
CHICKEN HOUSE'S
END ROAD

If more than one screen,
show location of each on sketch.