

SMITH

WATER WELL DRILLERS LOG

J 303

3 J 1

Date: 08-10-61 1961, Driller: W. G. Butler County SMITH

(Name)

260

(1) Owner of Land: Charles Miller
(Name)Raleigh, Miss.

(Address)

(2) Location: N 1/4 Sec. 14 T 2 R 74 miles West of Raleigh
(distance) (direction) (Nearest Town)(3) Topography: (Hilly) (Flat) (Level)(4) Purpose of Well: Domestic
(Domestic Irrigation
Municipal, Industrial, Other)

Information upon completion of well:


- (1) Diameter 2 inches.
- (2) Total Depth 140 feet.
- (3) Water Level 50 feet below top of ground.
- (4) Cased to 130, Size 2"
- (5) Screen: Size 2", Length 10'
- (6) Were any formations sealed against pollution?
_____ yes, _____ no.

If YES depth of formation _____

Why _____

Drillers Remarks: _____

Description & Color of Materials Sand, Clay, Red Clay, Shell, etc.	Thick- ness Feet	Depth Feet
Clay	1-	5
Rock	5-	6
White Chalk	6-	10
White + red Chalk	10-	20
Light Color Chalk	20-	25
Rock	25-	27
Sand + Rock	27-	30
Sand	30-	47
Chalk	47-	50
Sand	50-	75
Chalk	75-	90
Sand + Chalk	90-	100
Sand	100-	140

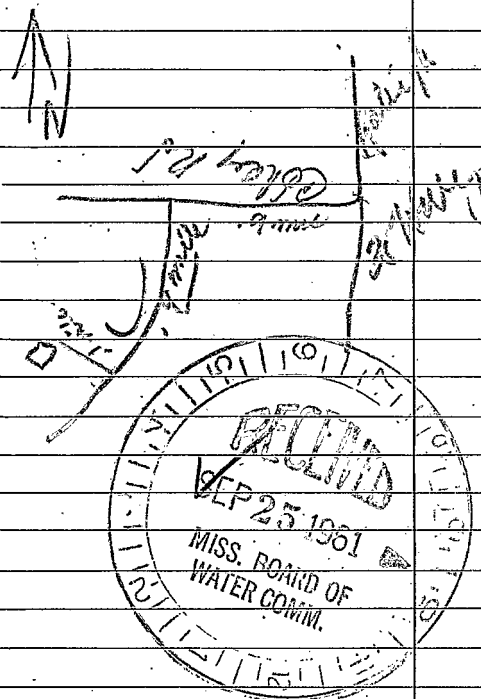

(Use Back Side)

Well No.

Retain this copy for your office files.

