

3 JZ  
4-4-61

WATER WELL DRILLERS LOG

J 302

Date: April 4, 1961, Driller: W. G. Butler County Smith  
(Name)

(1) Owner of Land: D.W. Middleton  
(Name)

Raleigh Rt. Miss  
(Address)

(2) Location: NE 1/4, NW 1/4, Sec. 9 T2R5E

8 miles West of Raleigh  
(distance) (direction) (Nearest Town)

(3) Topography:  (Hilly)  (Flat)  (Level)

(4) Purpose of Well: Domestic  
(Domestic Irrigation  
Municipal, Industrial, Other)

Description & Color of Materials  
Sand, Clay, Red Clay, Shell, etc.

Thick-  
ness  
Feet

Depth  
Feet

<u>Red Clay</u>	<u>1-10</u>	
<u>Chalk + Sand</u>	<u>10-25</u>	
<u>Sand</u>	<u>25-50</u>	

Information upon completion of well:

(1) Diameter: 2 inches.

(2) Total Depth: 50 feet.

(3) Water Level: 25 feet below top of ground.

(4) Cased to: 45, Size 2"


(5) Screen: Size 1/4, Length 5'

(6) Were any formations sealed against pollution?  
\_\_\_\_\_ yes, \_\_\_\_\_ no.

If YES depth of formation \_\_\_\_\_

Why \_\_\_\_\_

Drillers Remarks: \_\_\_\_\_

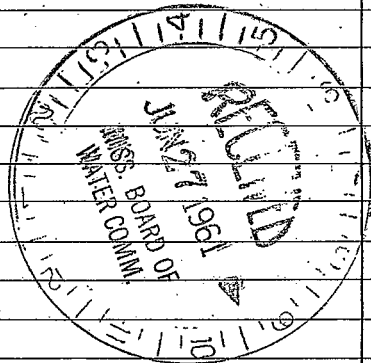

(Use Back Side)

Well No.

1914

1914

