

4 J3
5-8-61

WATER WELL DRILLERS LOG

J 301

Date: 5/8, 1961, Driller: James P. White County Smith
(Name)

(1) Owner of Land: G. F. Roberts
(Name)

Relig
(Address)

(2) Location: SE 1/4, SE 1/4, Sec. 14, T. 2 R. 7

2 miles W of Relig
(distance) (direction) (Nearest Town)

(3) Topography: (Hilly) (Flat) (Level)

(4) Purpose of Well: Chicken house
(Domestic Irrigation
Municipal, Industrial, Other)

Information upon completion of well:

- (1) Diameter 2 inches.
- (2) Total Depth 31 feet.
- (3) Water Level 18 feet below top of ground.
- (4) Cased to 36, Size 2"
- (5) Screen: Size 1 1/4", Length 5'
- (6) Were any formations sealed against pollution?
yes, no.

If YES depth of formation _____

Why _____


Drillers Remarks: _____

Description & Color of Materials
Sand, Clay, Red Clay, Shell, etc.

Thick-
ness
Feet

Depth
Feet

Red Clay	8	8
white Shell	10	18
Sand	13	31

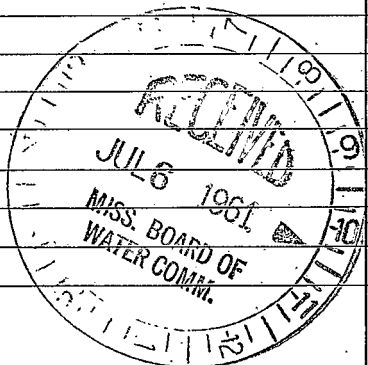

(Use Back Side)

Well No.

19 2/2

Stamps of the
Republic of the Philippines

1903
1904
1905

1906
1907
1908

1909

1910

1911

1912

1913

1914