

6 JB  
3-16-66

WATER WELL DRILLERS LOG

T

Date: March 16 1966 Driller: W. H. Butler County Smith  
(Name)

(1) Owner of Land: Horace J. J. J.  
(Name)  
Raleigh, Miss.  
(Address)

(2) Location: 2 1/2 miles  
10 miles S.W. of Raleigh  
(distance) (direction) (Nearest Town)

(3) Topography:  (Hilly)  (Flat)  (Level)

(4) Purpose of Well: Domestic  
(Domestic Irrigation  
Municipal, Industrial, Other)

Description & Color of Materials Sand, Clay, Red Clay, Shell, etc.	Thick- ness Feet	Depth Feet
Red Clay	1-5	
sand	5	10
Chalk	10	15
sand	15	20
Sand + Chalk	20	30
sand	30	57
Chalk + sand	57	60
sand -	60	101

Information upon completion of well:

(1) Diameter 2 inches.

(2) Total Depth 101 feet.


(3) Water Level \_\_\_\_\_ feet below top of ground.

(4) Cased to 94, Size 2"

(5) Screen: Size 2", Length 5"

(6) Were any formations sealed against pollution?  
\_\_\_\_\_ yes, \_\_\_\_\_ no.

If YES depth of formation \_\_\_\_\_  
Why \_\_\_\_\_  
Drillers Remarks: \_\_\_\_\_

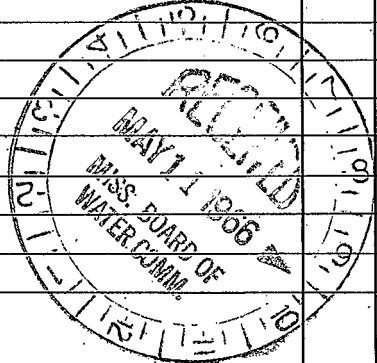

(Use Back Side)

Well No.

1880  
1881  
1882  
1901