

Date: Oct. 20, 1962, Driller: W. G. Butler County Smith
 (Name)

(1) Owner of Land: Howard Butler (Name)	Description & Color of Materials Sand, Clay, Red Clay, Shell, etc.	Thick- ness Feet	Depth Feet
Raleigh, Miss. Rt. (Address)	Clay	1-10	10-10
(2) Location: 1/4, 1/4, Sec. 16 T2 R5E	Sand & Chalk	10-35	10-35
6 miles West, of Raleigh (distance) (direction) (Nearest Town)	Rock + Chalk	35-40	35-40
(3) Topography: <input checked="" type="checkbox"/> (Hilly) <input type="checkbox"/> (Flat) <input type="checkbox"/> (Level)	Sand	40-50	40-50
(4) Purpose of Well: Domestic (Domestic Irrigation Municipal, Industrial, Other)			

Information upon completion of well:

(1) Diameter 2 inches.

(2) Total Depth 50 feet.

(3) Water Level 35 feet below top of ground.

(4) Cased to 42, Size 2"


(5) Screen: Size 2", Length 6'

(6) Were any formations sealed against pollution?
 yes, no.

If YES depth of formation _____

Why _____

Drillers Remarks: _____

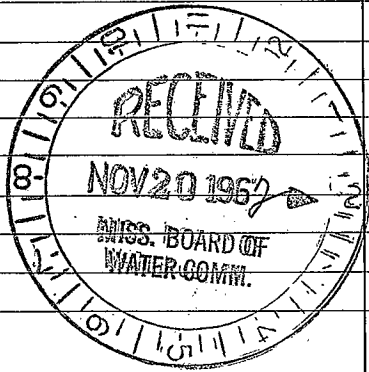

(Use Back Side)

Well No.

