

6 SMITH
KJ10
1-31-61

MISSISSIPPI BOARD OF WATER COMMISSIONERS

WATER WELL DRILLERS LOG

07

Date: 1/31 1961, Driller: James McGee County Smith

(Name)

(1) Owner of land: J. R. Purvis
 This well is located ^(Name) about 7 miles South of Hwy .18 out of Raleigh towards Brandon. (Address)
 (2) Location: 1/4, 1/4, Sec. 36 2N 6E T. R. 15 miles Southwest of Raleigh (distance) (direction) (Nearest Town)
 (3) Topography: X (Hilly) (Flat) (Level)
 (4) Purpose of Well: Domestic. (Domestic Irrigation Municipal, Industrial, Other)

Description & Color of Materials Sand, Clay, Red Clay, Shell, etc.	Thick- ness- Feet	Depth Feet
Red clay.		0-12
Red sand.		12-22
Sand.		22-32
Clay & sand.		32-42
Sand & stks. clay.		42-62
Sand. (Screen setting)		62-92


Information upon completion of well:

(1) Diameter 2 inches.
 (2) Total Depth 92 feet.
 (3) Water Level 60' feet below top of ground.
 (4) Cased to 82', Size 2"
 (5) Screen: Size 2", Length 10'
 (6) Were formations sealed against pollution?
 yes, X no.

If YES depth of formation

Why

Drillers Remarks: Fair well

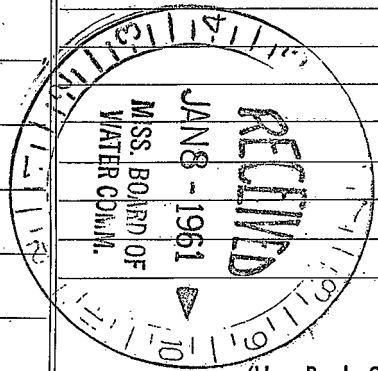

(Use Back Side)

Well No.

