

SMITH

MISSISSIPPI BOARD OF WATER COMMISSIONERS

J 11


WATER WELL DRILLERS LOG

Smith
Scott

5 6-5-63

Date: 6/5, 1963, Driller: Frank Dilling County: Scott
(Name)

(1) Owner of Land:	Description & Color of Materials Sand, Clay, Red Clay, Shell, etc.	Thick- ness Feet	Depth Feet
Simon Puckitt (Name) Raleigh Miss (Address)	Chalk	@	17
(2) Location: 1/4, 1/4, Sec. 5, 2N 7E T 8 R 6 miles west, of Raleigh (distance) (direction) (Nearest Town)	yard shale + rock		40
(3) Topography: _____ (Hilly) (Flat) (Level)	sand + clay		63
(4) Purpose of Well: Poultry Farm (Domestic Irrigation, Municipal, Industrial, Other)	lime sand		80
Information upon completion of well:	clay + sh + silt		90
(1) Diameter 2" inches.	blue clay		115
(2) Total Depth 327 feet.	silt sand		120
(3) Water Level 109 feet below top of ground.	blue clay		180
(4) Cased to 312, Size 2"	rock + sh + lime		220
(5) Screen: Size 2", Length 15ft.	lime + clay		253
(6) Were any formations sealed against pollution? yes, <u>no</u> .	blue clay		274
If YES depth of formation _____	sand + lime		280
Why _____	blue clay		302
Drillers Remarks: _____	shale + sh + lime sand		317
	sand + sh + shale		328

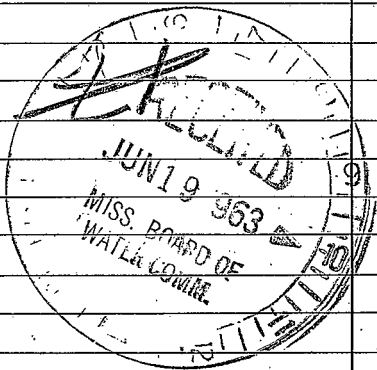

(Use Back Side)

Well No.

