

042

SMITH
J 12
3-68

MISSISSIPPI
BOARD OF WATER COMMISSIONERS
416 North State Street
Jackson, Mississippi 39201

WATER WELL DRILLERS LOG

Mar. 18 1968 W. D. Butler Smith
date well completed firm name county well located

LANDOWNER:

Kibon Bowens
Raleigh, Miss^{RT.}
(mailing address)

description of formations encountered

from to

Chalk + Rock	0	5
Chalk	5	20
Chalk + Sand	20	30
Sand	30	40
Sand + Chalk	40	60
Sand	60	70
Chalk + Sand	70	80

WELL LOCATION:

sec 16 T 2 N R 7 E
S miles W of Raleigh
(distance) (direction) (nearest town)

WELL PURPOSE: HOME
(home, irrigation, municipal, industrial)

WELL COMPLETION DATA:


- (1) diameter (inches) 2"
- (2) total depth (feet) 80'
- (3) static water level (feet) 100' ^{below} _{above} top of ground.
- (4) casing galv., 73' (material) (depth)
2" (size) if telescope see back.
- (5) screen 5' 73' (length) (depth to top)
2 (size), S.S. (material)
- (6) pump 1/2 (HP) 6 (yield gpm)
Electric (type power)
- (7) electric log No (yes or no)
- (8) how well bottom plugged 2" B.W.V.



DRILLERS REMARKS:

If well telescopes please sketch and show depths.

GROUND LEVEL

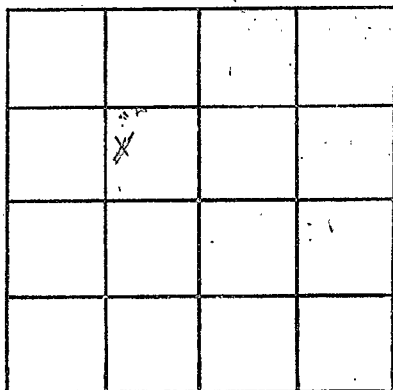

SECTION 16

Please indicate well location X.

ADDITIONAL INFORMATION

If more than one screen, show locations of each on sketch.