

SMITH
 J 14
 9-5-73

MISSISSIPPI
 BOARD OF WATER COMMISSIONERS
 416 North State Street
 Jackson, Mississippi 39201

WATER WELL DRILLERS LOG

CODED

9-5 1973 W.H. Bowers & Co. W Smith
 date well completed firm name county well located

LANDOWNER: Thomas McNeil
 Rt. 1
 Raleigh Miss.
 (mailing address)

description of formations encountered	from	to
Red Clay	0	10
Red sand	10	28
yellow clay	28	81
course white sand	81	102

WELL LOCATION:
 sec 27 T 2 N R 16 E
 4 miles S-W of Raleigh
 (distance) (direction) (nearest town)

WELL PURPOSE: Home
 (home, irrigation, municipal, industrial)

- WELL COMPLETION DATA:
- (1) diameter (inches) 2
 - (2) total depth (feet) 107
 - (3) static water level (feet) 65 below top of ground.
 - (4) casing Galv. (material), (depth)
 2" (size) if telescope see back.
 - (5) screen 4 (length), (depth to top)
 07 (size), Stainless S (material)
 - (6) pump 1-H.P. 6 (HP) (yield gpm)
 Elec. (type power)
 - (7) electric log NO (yes or no)
 - (organization running log)
 - (8) how well bottom plugged Wash, valve

CODED


DRILLERS REMARKS:

SEP 26 1973

MISSISSIPPI
 BOARD OF WATER COMMISSIONERS
 JACKSON, MISSISSIPPI

If well telescopes please sketch and show depths.

GROUND LEVEL

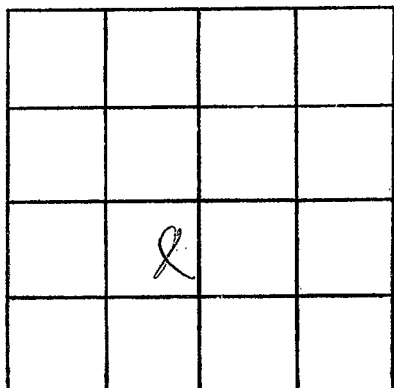

SECTION 27

Please indicate well location X.

ADDITIONAL INFORMATION

If more than one screen,
show locations of each on sketch.