

**MISSISSIPPI
BOARD OF WATER COMMISSIONERS**
416 North State Street
Jackson, Mississippi 39201

WATER WELL DRILLERS LOG

Smith
J 15
7-68

CODED

7-16 19*68* *W.K. Barnes Water Wells* *Smith*
date well completed firm name county well located

LANDOWNER: *Ms. Cullen Smith*
Route 1
Miss. Miss.
(mailing address)

description of formations encountered	from	to
<i>Red Clay</i>	<i>0</i>	<i>15</i>
<i>Red Sand</i>	<i>15</i>	<i>30</i>
<i>White Dry Sand</i>	<i>30</i>	<i>60</i>
<i>Yellow Clay</i>	<i>60</i>	<i>82</i>
<i>Fine Sand</i>	<i>82</i>	<i>140</i>
<i>Water Sand</i>	<i>140</i>	<i>157</i>

WELL LOCATION:
sec. *13* T. *2* N. R. *7* E.
4 miles *South* of *Perleigh*
(distance) (direction) (nearest town)

WELL PURPOSE: *Chicken House*
(home, irrigation, municipal, industrial)

WELL COMPLETION DATA:

(1) diameter (inches) *2*

(2) total depth (feet) *157*

(3) static water level (feet) *130* below above top of ground.

(4) casing *Galv.* *153*
(material) (depth)
2" if telescope see back.
(size)

(5) screen *4'* *153*
(length) (depth to top)
2" *Stainless Steel*
(size) (material)

(6) pump *Red* *3*
(HP) (yield gpm)
Elec.
(type power)

(7) electric log *no*
(yes or no)

(organization running log)

(8) how well bottom plugged: *Washed*

CODED


AUG 8 1968

MISS. BD. OF
WATER COMM.

DRILLERS REMARKS:

If well telescopes please sketch and show depths.

GROUND LEVEL

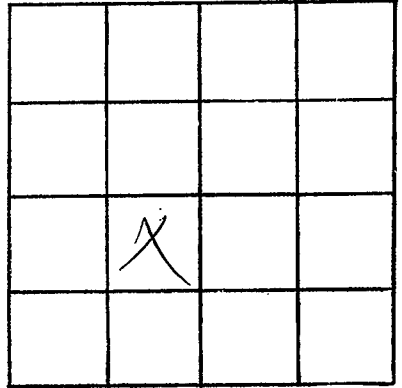

SECTION 13

Please indicate well location X.

ADDITIONAL INFORMATION

If more than one screen, show locations of each on sketch.