

Smith
J 16
3-27-70

MISSISSIPPI
 BOARD OF WATER COMMISSIONERS
 416 North State Street
 Jackson, Mississippi 39201

AD WATER WELL DRILLERS LOG

Mar 27 19 70 W. G. Butler Smith
 date well completed firm name county well located

LANDOWNER:

Ronald Bishop
Rt. 3, Maace
 (mailing address)

description of formations encountered

from to

Clay + Sand 0 110
Sand 110 120
Clay 120 130

WELL LOCATION:

sec 14 T 2 N 042 R 6 E
6 1/2 miles SW of Raleigh
 (distance) (direction) (nearest town)

WELL PURPOSE:

Home
 (home, irrigation, municipal, industrial)

WELL COMPLETION DATA:

(1) diameter (inches) 2
 (2) total depth (feet) 90

(3) static water level (feet) below
 top of ground. above

(4) casing galv., 85'
 (material) (depth)

2"
 (size) If telescope see back.

(5) screen 5, 85
 (length) (depth to top)

2", 55'
 (size) (material)

(6) pump 3/4, 4
 (HP) (yield gpm)

Electric
 (type power)

(7) electric log No
 (yes or no)

(organization running log)

(8) how well bottom plugged 2" B/W


JUN 5 1970

MISS. BD. OF
 WATER COM.

DRILLERS REMARKS:

If well telescopes please sketch and show depths.

GROUND LEVEL

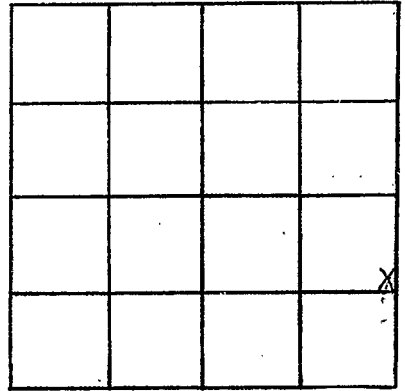

SECTION 14

Please indicate well location X.

ADDITIONAL INFORMATION

If more than one screen,
show locations of each on sketch.