

Smith
J 17
6-8-70

MISSISSIPPI
BOARD OF WATER COMMISSIONERS
416 North State Street
Jackson, Mississippi 39201

CODED

WATER WELL DRILLERS LOG

June 8 1970 W. A. Butler Smith
date well completed firm name county well located

LANDOWNER:

Billie Carl Smith
Raleigh, Miss
RT-1 (mailing address)

description of formations encountered

from to

clay & sand	0	20
sand	20	40
sand & rock	40	50
clay	50	65
sand, H.C. clay	65	80
sand	80	95
clay	95	100

WELL LOCATION:

sec. 2 T 2 N R 3 E
S W
1 1/2 miles W. of Raleigh
(distance) (direction) (nearest town)

WELL PURPOSE:

Home
(home, irrigation, municipal, industrial)

WELL COMPLETION DATA:

- (1) diameter (inches) 2"
- (2) total depth (feet) 100'
- (3) static water level (feet) 50' below top of ground.
- (4) casing 9211 (material), 90' (depth), 24 (size) if telescope see back.
- (5) screen 5' (length), 90 (depth to top), 2" (size), SS (material)
- (6) pump 1 (HP), 15 (yield gpm), Electric (type power)
- (7) electric log NO (yes or no)
- (organization running log)
- (8) how well bottom plugged 2" B.W.V.

CODED


JUL 2 1970

DRILLERS REMARKS:

MISS. BD. OF
WATER COMMISSIONERS

If well telescopes please sketch and show depths.

GROUND LEVEL

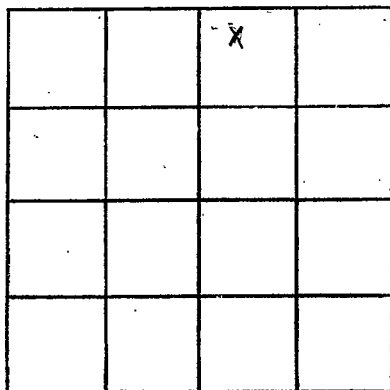

SECTION 2

Please indicate well location X.

ADDITIONAL INFORMATION

If more than one screen,
show locations of each on sketch.