

SMITH
 J 19
 10-5-70

MISSISSIPPI
 BOARD OF WATER COMMISSIONERS
 416 North State Street
 Jackson, Mississippi 39201

CODED

WATER WELL DRILLERS LOG

10-5-70 date well completed 1970 W.K. Barnes Water Wells firm name 3 Smith county well located

LANDOWNER: Billy L. Poe
Rt. 1
Raleigh, Miss.
 (mailing address)

description of formations encountered	from	to
<u>Red Clay</u>	<u>0</u>	<u>8</u>
<u>Red Sand</u>	<u>8</u>	<u>40</u>
<u>yellow clay</u>	<u>110</u>	<u>60</u>
<u>Course sand</u>	<u>60</u>	<u>80</u>

WELL LOCATION:
 sec. 26 T 2 N R 16 E
S W
4 miles S.W. of Raleigh
 (distance) (direction) (nearest town)

WELL PURPOSE: HOME
 (home, irrigation, municipal, industrial)

- WELL COMPLETION DATA:
- (1) diameter (inches) 2"
 - (2) total depth (feet) 80
 - (3) static water level (feet) 60 below above top of ground.
 - (4) casing Galv. (material), (depth) 2" if telescope see back. (size)
 - (5) screen 4' (length), (depth to top) 08 slot S.S. (size) (material)
 - (6) pump 3HP (HP), (yield gpm) 8
 - (type power) elec.
 - (7) electric log no. (yes or no)
 - (organization running log)
 - (8) how well bottom plugged wash water

CODED


DRILLERS REMARKS:

NOV 18 1970

MISS. BD. OF
 WATER COMM.

If well telescopes please sketch and show depths.

GROUND LEVEL

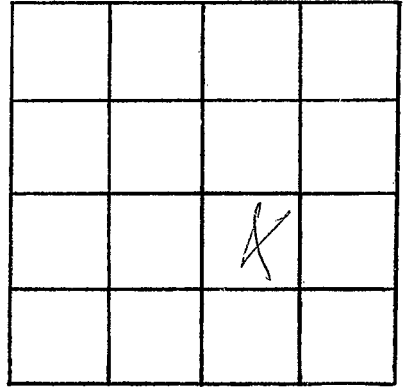

SECTION 26

Please indicate well location X.

ADDITIONAL INFORMATION

If more than one screen,
show locations of each on sketch.