

GW01532

J. ELOG # 175

SMITH
J 21
5-10-72

MISSISSIPPI
BOARD OF WATER COMMISSIONERS
416 North State Street
Jackson, Mississippi 39201

WATER WELL DRILLERS LOG

CODED

510 1972 Singer-Lopez Central Smith
date well completed firm name county well located

LANDOWNER:	description of formations encountered	from	to
Traylor Water Association	Red Sandy Clay	0	15
Raleigh, Miss	Lower Red Sand	15	62
(mailing address)	Hard Clay	62	294
WELL LOCATION:	Fine Sand	294	328
sec. 13 T. 2 N. R. 6 E	Hard Clay	328	414
15 miles N.W. of Raleigh	Rock	414	416
(distance) (direction) (nearest town)	Shale	416	423
WELL PURPOSE: Domestic	Hard Lemo	423	450
(home, irrigation, municipal, industrial)	Sand & Shale Strata	450	550
WELL COMPLETION DATA:	Hard Clay	550	780
(1) diameter (inches) 8"	Sandy Shale	780	801
(2) total depth (feet) 1105'	Hard Shale	801	886
(3) static water level (feet) 310 below top of ground.	Rock	886	888
(4) casing Steel 1035' (material) (depth)	Sand & Clay (breaks)	888	959
8" if telescope see back.	Hard Shale	959	967
(size) of 45' 26"	Fine Sand	967	1100
(5) screen 60' 1039' (length) (depth to top)	Shale	1100	1105
6" Stainless Steel (size) (material)			
(6) pump 30 700 (HP) (yield gpm)			
Electric (type power)			
(7) electric log Yes (yes or no)			
Miss. Geol. Survey (organization running log)			
(8) how well bottom plugged Valve			
DRILLERS REMARKS:			

Plugged and Abandoned

CODED

Plugged and Abandoned

JUN - 1 1972


by Green 7/3/72

MISS. BD. OF WATER COMM.

(X)

If well telescopes please sketch and show depths.

GROUND LEVEL

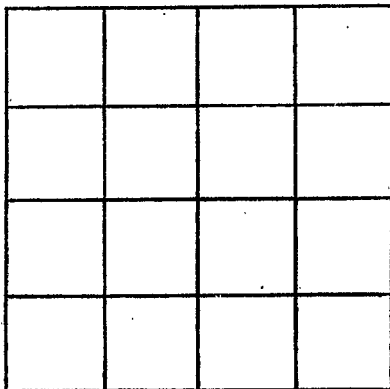

SECTION _____

Please indicate well location X.

ADDITIONAL INFORMATION

If more than one screen, show locations of each on sketch.