

MISSISSIPPI DEPARTMENT OF NATURAL RESOURCES

Bureau of Land and Water Resources

Southport Mall

P.O. Box 10631

CODED

Jackson, Mississippi 39209

WATER WELL DRILLERS LOG

SMITH
J 26
12/28/82

12-28-82 *Griner Drilling Service, Inc.* *Smith*

date well completed

firm name

county well located

LANDOWNER:	description of formations encountered	from	to
<i>Erter Drilling</i> <i>144 Elk Place</i> <i>Suite 1502</i> <i>New Orleans, La</i>	<i>clay, rock</i>	<i>0</i>	<i>42</i>
WELL LOCATION: <i>1100'S & 70112</i> sec. <i>33</i> T. <i>2</i> N. R. <i>7</i> E. <i>72</i> W. <i>625' W</i>	<i>streaked</i>	<i>42</i>	<i>336</i>
<i>No. 1 well</i> <i>Raleigh Field</i> <i>2 1/2 miles</i> (direction) (nearest town)	<i>clay</i>	<i>336</i>	<i>672</i>
WELL PURPOSE: <i>oil field supply</i> (home, irrigation, municipal, industrial)	<i>sand, clay, shell</i>	<i>672</i>	<i>790</i>
WELL COMPLETION DATA:	<i>sand</i>	<i>790</i>	<i>850</i>
(1) diameter (inches) <i>3"</i>	<i>clay</i>	<i>850</i>	<i>861</i>
(2) total depth (feet) <i>861'</i>			
(3) static water level (feet) <i>100'</i> <input checked="" type="checkbox"/> below <input type="checkbox"/> above top of ground.			
(4) casing <i>steel</i> <i>855'</i> (material) (depth)			
<i>3"</i> (size) if telescope see back.			
(5) screen <i>42'</i> <i>813'</i> (length) (depth to top)			
<i>3"</i> <i>perforated</i> (size) (material)			
(6) pump <i>—</i> <i>80</i> (HP) (yield gpm)			
<i>ac</i> (type power)			
(7) electric log <i>—</i> (yes or no)			
<i>—</i> (organization running log)			
(8) how well bottom plugged <i>sand</i> <i>peel</i>			
DRILLERS REMARKS:			

CODED

CODED


DEPT. OF NATURAL RESOURCES
BUREAU OF LAND & WATER RESOURCES

JAN - 8 1983

RECEIVED

If well telescopes please sketch and show depths.

GROUND LEVEL

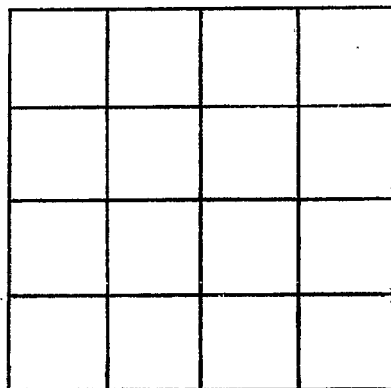

SECTION _____

Please indicate well location X.

ADDITIONAL INFORMATION

If more than one screen,
show locations of each on sketch.