




If well telescopes please sketch and show depths.

GROUND LEVEL

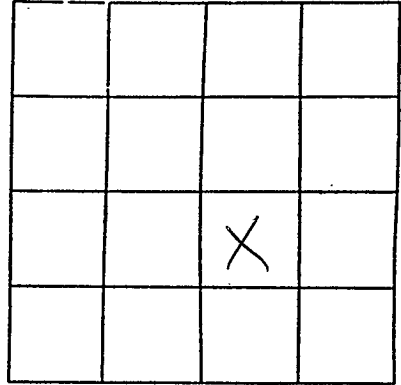

SECTION 23

Please indicate well location X.

Pump Capacity (GPM)	No. of Stages	Setting Depth
35		155 FT.
PUMP TEST		
Well yielded _____ GPM with a drawdown of _____ ft. after _____ hours of pumping		

LOG DATA

TYPE OF LOG RUN (Circle One):	No Log Run.
Electric, Gamma Ray, Density, Sonic, Neutron,	
Other (Describe) _____	
Name of Organization Running Log	

GEOLOGIC DATA (Office Use Only)

Surface Elev.	Geologic Unit	Unit Thickness	Depth to Top
Subs. SWL	Date	Analysis	Aquifer Test

Driller's Remarks

---

---

If more than one screen, show location of each on sketch.