

Smith  
 J 2000

MISSISSIPPI  
 BOARD OF WATER COMMISSIONERS  
 416 North State Street  
 Jackson, Mississippi 39201

WATER WELL DRILLERS LOG

April 7, 1982 Tom Yuffert Smith  
 date well completed firm name county well located

LANDOWNER: J.C. Luckey  
 Raleigh (mailing address)

WELL LOCATION:  
 sec. 36 T. 20 R. 7 E  
 5 miles south of Raleigh  
 (distance) (direction) (nearest town)

WELL PURPOSE:  
 (home, irrigation, municipal, industrial)

- WELL COMPLETION DATA:
- (1) diameter (inches) 4"
  - (2) total depth (feet) 300'
  - (3) static water level (feet) 220' below top of ground.
  - (4) casing (material) PC (depth) 280'
  - (5) screen (size) 20' (length) (depth to top)
  - (6) pump (HP) 1 (material) 10 (yield gpm)
  - (7) electric log (yes or no)
  - (8) how well bottom plugged BWS

description of formations encountered	from	to
0' - 1' - Topsoil		
1' - 10' - Sandy Chalk		
10' - 100' - Sand		
100' - 110' - Chalk		
110' - 130' - Sand		
130' - 160' - Chalk		
160 - 200' - Limestone		
200' - 280' - Sand		

DEPT. OF NATURAL RESOURCES  
 BUREAU OF LAND & WATER RESOURCES


JUN 25 1992

RECEIVED

DRILLERS REMARKS:

If well telescopes please  
sketch and show depths.

GROUND LEVEL

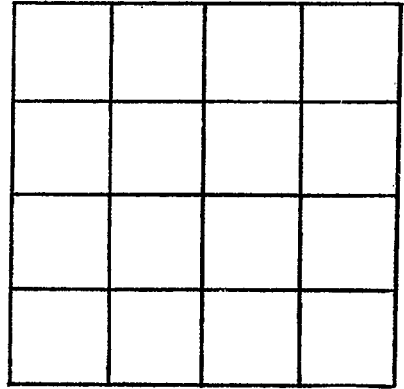

SECTION \_\_\_\_\_

Please indicate well location X.

ADDITIONAL INFORMATION

If more than one screen,  
show locations of each on sketch.