

Filed 0 1 4.7
K-392

WATER WELL DRILLERS LOG

SMITH
3 K 3

Date: Nov. 4, 1960, Driller: W. G. BUTLER County SMITH
11-4-60 (Name)

(1) Owner of Land: MYRA CRAFT
(Name)
RALEIGH MISS.
(Address)
S 1/2 NW 1/4 NE 1/4 of SW 1/4 N 25th & NE 1/4
(2) Location: NE 1/4, NW 1/4, Sec. 9 T2R8
2 miles East, of Raleigh
(distance) (direction) (Nearest Town)
(3) Topography: (Hilly) (Flat) (Level)
(4) Purpose of Well: Domestic
(Domestic Irrigation
Municipal, Industrial, Other)


| Description & Color of Materials Sand, Clay, Red Clay, Shell, etc. | Thick- ness Feet | Depth Feet |
|---|------------------------|---------------|
| Clay | 17 | 10 |
| Blue Chalk | 10 | 20 |
| " " | 20 | 32 |
| " " | 30 | 38 |
| ROCK | 38 | 40 |
| + Shell | 40 | 45 |
| ROCK | 45 | 50 |
| Rock + Shell | 50 | 60 |
| " " | 60 | 70 |
| Sand + shell | 70 | 80 |
| " " | 80 | 88 |
| Chalk | 88 | 90 |
| Chalk lignite | 90 | 95 |
| little fine sand | 95 | 100 |
| " " | 100 | 105 |
| Chalk + sand | 105 | 110 |
| sand + chalk | 110 | 120 |
| " " | 120 | 128 |
| Sand | 128 | 130 |
| " " | 130 | 140 |
| Spud 520 RT | | |

Information upon completion of well:

(1) Diameter 2 inches.
(2) Total Depth 140 feet.
(3) Water Level _____ feet below top of ground.
(4) Cased to _____, Size _____
(5) Screen: Size 2, Length 10'
(6) Were any formations sealed against pollution?
_____ yes, _____ no.

If YES depth of formation 128
Why _____

Drillers Remarks: Raleigh 2 mi
No stain
Slightly hard

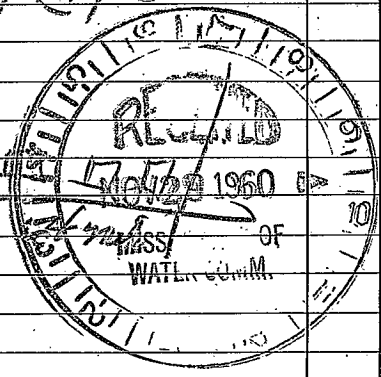

(Use Back Side)

Well No.

1875

1876

1877

1878

1879

1880

1881

1882