

6 K6
9-23-60

WATER WELL DRILLERS LOG

K-301

Date: 9/23, 1960, Driller: James A. White County Smith

(Name)

- (1) Owner of Land: D.A. Henderson
(Name)
Rt One Taylorsville, Miss
(Address)
- (2) Location: SE 1/4, SE 1/4, Sec. 32 T. 7 R. 2E
6 miles South, of Polign
(distance) (direction) (Nearest Town)
- (3) Topography: X
(Hilly) (Flat) (Level)
- (4) Purpose of Well: Chicken farm
(Domestic Irrigation
Municipal, Industrial, Other)

| Description & Color of Materials Sand, Clay, Red Clay, Shell, etc. | Thick- ness Feet | Depth Feet |
|---|------------------------|---------------|
| Red clay | 15 | 15 |
| Red Sand | 30 | 45 |
| water sand | 18 | 53 |


Information upon completion of well:

- (1) Diameter 2 inches.
- (2) Total Depth 53 feet.
- (3) Water Level 45 feet below top of ground.
- (4) Cased to 47, Size 2"
- (5) Screen: Size 1 1/2", Length 5 ft.
- (6) Were any formations sealed against pollution?
_____ yes, _____ no.

If YES depth of formation _____

Why _____

Drillers Remarks: _____

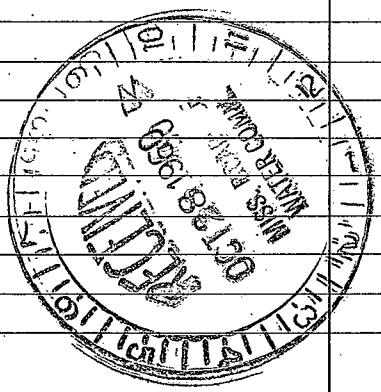

(Use Back Side)

Well No.

