

SMITH

6 K 10 MISSISSIPPI BOARD OF WATER COMMISSIONERS

5-19-66

WATER WELL DRILLERS LOG

Date: 5-19, 1966, Driller: LEACH County: Smith

(1) Owner of Land: Latrell McMillan (Name)
Bay Springs Miss. (Address)
(2) Location: 1/4, 1/4, Sec. 10 T. 8 E. R.
12 miles west of Bay Springs (distance, direction, Nearest Town)
(3) Topography: (Hilly) (Flat) (Level)
(4) Purpose of Well: (Domestic Irrigation) (Municipal, Industrial, Other)


Table with 3 columns: Description & Color of Materials (Sand, Clay, Red Clay, Shell, etc.), Thickness Feet, Depth Feet. Rows include: Sand & clay (50), Sand & gravel (70), Blue clay (60), Clay & rock (32), Sand & clay (25), Rock (10), Shell (15), Sand (26).

Information upon completion of well:

(1) Diameter: 2 inches.
(2) Total Depth: 285 feet.
(3) Water Level: 165 feet below top of ground.
(4) Cased to: 275, Size: 2"
(5) Screen: Size: 2 1/2", Length: 10
(6) Were any formations sealed against pollution?
yes, no.

If YES depth of formation
Why

Drillers Remarks: low yield
Yield in gpm: 8
Size pump: 2 hp air comp.
Type power: electric

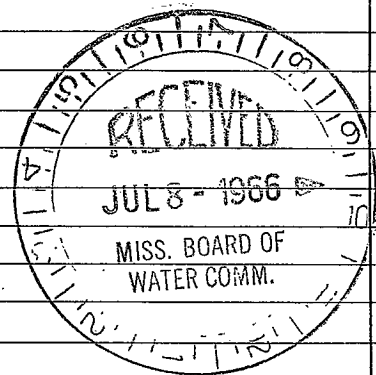

Total 285

