

6 K11

0 K 305

4-3-61

WATER WELL DRILLERS LOG

Date April 3, 1961, Driller: W.G. Butler County Smith

(Name)

(1) Owner of Land: Cooper Moore  
 (Name)

Raleigh Miss, Pt.  
 (Address)

(2) Location: SE 1/4 of SE 1/4 SW 1/4 of NW 1/4 of SW 1/4 of Sec. 22, T. 28R.  
 (Section, Township, Range)

5 miles South, of Raleigh  
 (distance) (direction) (Nearest Town)

(3) Topography: ✓  
 (Hilly) (Flat) (Level)

(4) Purpose of Well: Domestic  
 (Domestic Irrigation, Municipal, Industrial, Other)

Description & Color of Materials Sand, Clay, Red Clay, Shell, etc.	Thick- ness Feet	Depth Feet
Chalk	1-15	
Sand + Chalk	15-35	
Chalk + Rock	35-70	
Sand	70-90	

Information upon completion of well:

(1) Diameter 2 inches.

(2) Total Depth 90 feet.

(3) Water Level 30 feet below top of ground.


(4) Cased to 80', Size 2"

(5) Screen: Size 2", Length 10'

(6) Were any formations sealed against pollution?  
   yes,    no.

If YES depth of formation     
 Why   

Drillers Remarks:     
    
    
  

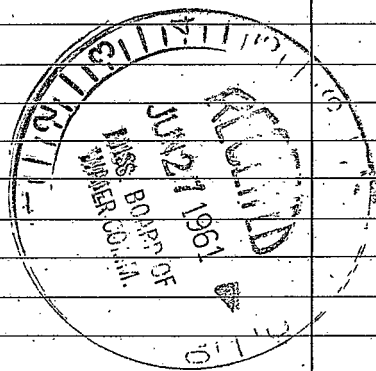

(Use Back Side)

Well No.

Handwritten header text, possibly a title or date.

Main body of handwritten text, starting with a large initial or word.

Table with multiple rows and columns, containing handwritten entries.

Handwritten text line, possibly a continuation of the main text.

Handwritten text line, possibly a signature or date.

Handwritten text on the right side of the page.

Handwritten text at the bottom of the page.