

SMITH
5 K13
11-9-62

MISSISSIPPI BOARD OF WATER COMMISSIONERS

0

WATER WELL DRILLERS LOG

Date: Nov. 9, 1962, Driller: W. G. Butler County Smith
(Name)

(1) Owner of Land: Obed H. Windham
(Name)
Raleigh, Miss
(Address)

(2) Location: 20.8E 12.15N
2 1/2 miles east of Raleigh
(distance) (direction) (Nearest Town)

(3) Topography: (Hilly) (Flat) (Level)

(4) Purpose of Well: Domestic
(Domestic Irrigation
Municipal, Industrial, Other)

Description & Color of Materials Sand, Clay, Red Clay, Shell, etc.	Thick-ness Feet	Depth Feet
Chalk	1-5	
Sand	5-15	
Rock	15-20	
Rock & Chalk	30-55	
shale + sand	55-70	
shell + hicknito	70-80	
Chalk	80-90	
Chalk + hicknito	90-100	
Fine sand	100-105	
Chalk	105-110	
Fine sand	110-150	

Information upon completion of well:

(1) Diameter 2" inches.

(2) Total Depth 150 feet.

(3) Water Level 50 feet below top of ground.

(4) Cased to 136', Size 2"


(5) Screen: Size 2", Length 11'

(6) Were any formations sealed against pollution?
_____ yes, _____ no.

If YES depth of formation _____

Why _____

Drillers Remarks: _____

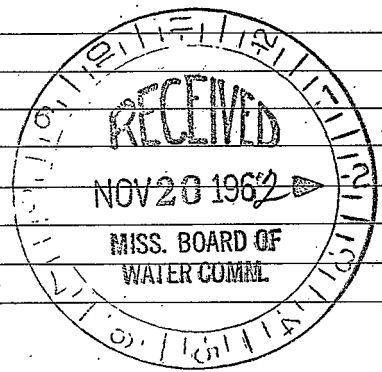

(Use Back Side)

Well No.

July 10th 1954

Dear Mr. [Name]:

I have been thinking about you a great deal lately. I hope you are all well. I am well at the moment.

I am writing you because I want to let you know that I have a job now. It is a very interesting one.

I have been very busy lately but I will try to get back to you as soon as possible.

I hope you will write back soon. I will be waiting for your reply.

Yours truly,

[Name]