

SMITH
SK14
8-24-63

MISSISSIPPI BOARD OF WATER COMMISSIONERS

WATER WELL DRILLERS LOG

Date: Aug 24, 1963, Driller: M. G. Butler County Smith
(Name)

(1) Owner of Land: Jimmy D. Craft
(Name)
Raleigh, Miss.
(Address)

(2) Location: 1/4, 1/4, Sec. 33 T8N R15E
_____ miles _____ of _____
(distance) (direction) (Nearest Town)

(3) Topography: (Hilly) (Flat) (Level)

(4) Purpose of Well: Domestic
(Domestic Irrigation
Municipal, Industrial, Other)

| Description & Color of Materials Sand, Clay, Red Clay, Shell, etc. | Thick- ness- Feet | Depth Feet |
|---|-------------------------|---------------|
| Red Clay | 1-10 | |
| Sand | 10-50 | |
| Chalk & Sand | 50-60 | |
| Chalk | 60-65 | |
| Sand | 65-74 | |
| Rock | 74-80 | |
| Rock & Chalk | 80-90 | |

Information upon completion of well:

(1) Diameter 2 inches.

(2) Total Depth 90 feet.

(3) Water Level _____ feet below top of ground.

(4) Cased to 66, Size 2"


(5) Screen: Size 2", Length 5'

(6) Were any formations sealed against pollution?
_____ yes, _____ no.

If YES, depth of formation _____

Why _____

Drillers Remarks: _____

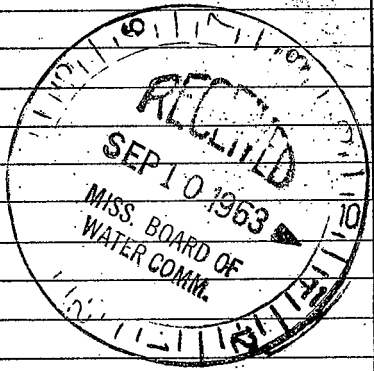

(Use Back Side)

Well No.

