

SMITH  
 K 15 <sup>CODED</sup>  
 5-68

MISSISSIPPI  
 BOARD OF WATER COMMISSIONERS  
 416 North State Street  
 Jackson, Mississippi 39201

WATER WELL DRILLERS LOG

5-20 1968 W. K. Barnes Waterwells Smith  
 date well completed firm name county well located

LANDOWNER: Jack Rainer  
 RT. 1  
 Raleigh miss.  
 (mailing address)

WELL LOCATION:  
 sec. 18 T 2 N R. 12 E  
 S W  
 South 3.4 miles of Raleigh  
 (distance) (direction) (nearest town)

description of formations encountered	from	to
Red clay	0	25
Red sand	25	60
yellow clay	60	110
waty sand	110	132

WELL PURPOSE: Home  
 (home, irrigation, municipal, industrial)

WELL COMPLETION DATA:

(1) diameter (inches) 2

(2) total depth (feet) 132

(3) static water level (feet) 80 below top of ground.

(4) casing Galv. 126 (material) (depth)  
 1 1/4 (size) if telescope see back.

(5) screen 6' 126 (length) (depth to top)  
 1 1/4 (size) 60 gauge (material)

(6) pump Red 3 (HP) (yield gpm)  
 Elec. (type power)

(7) electric log no (yes or no)  
 (organization running log)

(8) how well bottom plugged wash valve

CODED

5 1968  
 MISS. BOARD OF  
 WATER COMMISSIONERS


DRILLERS REMARKS:

If well telescopes please sketch and show depths.

GROUND LEVEL

126 ft. Galv. Pipe

6' 80 gauge Extension

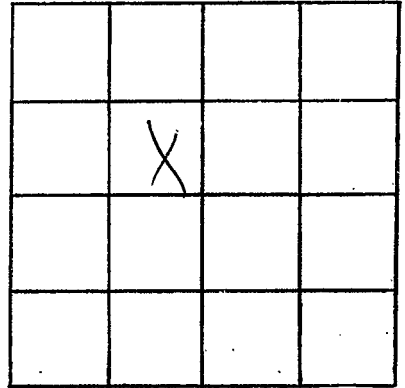

SECTION \_\_\_\_\_

Please indicate well location X.

ADDITIONAL INFORMATION

If more than one screen, show locations of each on sketch.