

SMITH

K18

11-2-70

MISSISSIPPI
 BOARD OF WATER COMMISSIONERS
 416 North State Street
 Jackson, Mississippi 39201

CODED

WATER WELL DRILLERS LOG

NOV. 2

19

20 W. G. Butler

SMITH

date well completed

firm name

county well located

LANDOWNER: P. C. Craft

description of formations encountered

from

to

Raleigh Miss.

Clay Rock - SAND 0 20

Clay Rock - Shell 20 60

Clay + SAND 60 80

SAND + Lenticite Shell 80 100

Clay - Lenticite - Shell 100 120

Clay + SAND 120 140

SAND 140 150

(mailing address)

WELL LOCATION:

sec. 15 T 20 S R 8 E
 3 miles E of Raleigh
 (distance) (direction) (nearest town)

WELL PURPOSE: Home
 (home, irrigation, municipal, industrial)

WELL COMPLETION DATA:

(1) diameter (inches) 2"
 (2) total depth (feet) 150
 (3) static water level (feet) _____ below above top of ground.

(4) casing galv. 137'
 (material) (depth)
 2" if telescope see back.
 (size)

(5) screen 10' 137'
 (length) (depth to top)
 2" SS
 (size) (material)

(6) pump _____ (HP) _____ (yield gpm)
 9.1 electric
 (type power)

(7) electric log No
 (yes or no)

(organization running log)

(8) how well bottom plugged 2" BWV.

DRILLERS REMARKS:


CODED

DEC 7 1970

MISS. BD. OF WATER COMM.

If well telescopes please sketch and show depths.

GROUND LEVEL

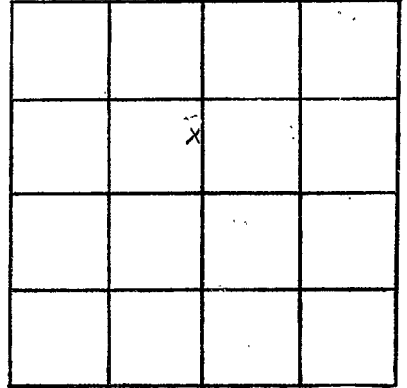

SECTION 15

Please indicate well location X.

ADDITIONAL INFORMATION

If more than one screen,
show locations of each on sketch.