

Smith
 4-22
 12-18-79

MISSISSIPPI
 BOARD OF WATER COMMISSIONERS
 416 North State Street
 Jackson, Mississippi 39201

WATER WELL DRILLERS LOG

12-18-79 date well completed
 Griner Drilling Smith firm name
 county well located

LANDOWNER:
 Harkins Company
 1310 Standard Life Bldg
 Jackson, MS
 (mailing address)

description of formations encountered	from	to
SAND	0	63
rock - chalk	63	147
SAND	147	210
chalk	210	882
SAND	882	945

HAWKINS NO. 1 33-7
 WELL LOCATION: 2995 104 21/2 W sec. 33 T. 20 N. R. 8 E of Raleigh (distance) miles (direction) of (nearest town) W 1/2 sec 30

WELL PURPOSE: oil field supply
 (home, irrigation, municipal, industrial)

WELL COMPLETION DATA:

- (1) diameter (inches) 3"
- (2) total depth (feet) 945'
- (3) static water level (feet) 180' ^{below} top of ground.
- (4) casing steel 945' (material) (depth) 3" (size) if telescope see back.
- (5) screen 42' 903' (length) (depth to top) 3" perforated (size) (material)
- (6) pump AC 70 (HP) (yield gpm) (type power)
- (7) electric log (yes or no)
- (organization running log)

(8) how well bottom plugged orange peel

DRILLERS REMARKS:


DEPT. OF NATURAL RESOURCES
 BUREAU OF LAND & WATER RESOURCES

JAN 9 1980

RECEIVED

If well telescopes please sketch and show depths.

GROUND LEVEL

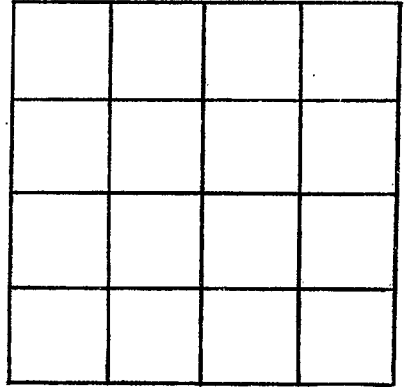

SECTION _____

Please indicate well location X.

ADDITIONAL INFORMATION

If more than one screen,
show locations of each on sketch.