

Smith
 K 2000
 7-19-79

MISSISSIPPI
 BOARD OF WATER COMMISSIONERS
 416 North State Street
 Jackson, Mississippi 39201

WATER WELL DRILLERS LOG

SMITH
 Jay Lovills miss
 Toad Farm
 county well located

7-19 1979 W.K. RARNESS
 date well completed firm name

LANDOWNER: <u>Ray Crosby</u>	description of formations encountered	from	to
<u>JAY LOVILLS miss</u>			
<u>Route one</u>	<u>Red Clay</u>	<u>0</u>	<u>20</u>
(mailing address)	<u>white chbck</u>	<u>20</u>	<u>30</u>
	<u>COOKS SAND</u>	<u>30</u>	<u>60</u>

WELL LOCATION:
 sec. 31 T 2 N R 8 E
 S W
10 miles N.W. of HOT C. OFF
 (distance) (direction) (nearest town)

WELL PURPOSE: Home U.S.
 (home, irrigation, municipal, industrial)

- WELL COMPLETION DATA:
- (1) diameter (inches) 2"
 - (2) total depth (feet) 60 feet
 - (3) static water level (feet) 40 below top of ground.
 - (4) casing Calc. 60
 (material) (depth)
2"
 (size) if telescope see back.
 - (5) screen 4ft -
 (length) (depth to top)
2 1/2" Stainless Steel
 (size) (material)
 - (6) pump Rod pump 6
 (HP) (yield gpm)
Fct.
 (type power)
 - (7) electric log NO
 (yes or no)
N.A.
 (organization running log)
 - (8) how well bottom plugged WASH
WAVE

DRILLERS REMARKS: None


Miss. Board of Water Comm.

SEP 10 1979

RECEIVED

If well telescopes please sketch and show depths.

GROUND LEVEL

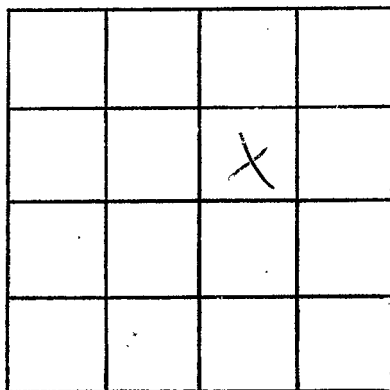

SECTION _____

Please indicate well location X.

ADDITIONAL INFORMATION

Lined area for additional information.

If more than one screen, show locations of each on sketch.