

MISSISSIPPI DEPARTMENT OF NATURAL RESOURCES
Bureau of Land and Water Resources

P.O. Box 10631

Jackson, Mississippi 39209

WATER WELL DRILLERS LOG

COUNTY WELL LOCATED Smith	
WELL NUMBER K	CODED
DATE WELL COMPLETED 2001 6-27-90	

PERMIT NUMBER
NAME OF DRILLING FIRM Roy V. West

NAME & MAILING ADDRESS OF LANDOWNER Marty Robinson		
Rt 2		
Raleigh MS 39153		
WELL LOCATION: SEC	TOWNSHIP	RANGE
23	2	N 8 E
DISTANCE	DIRECTION	NEAREST TOWN
6 Miles	SE	of Raleigh
OTHER LANDMARK		
WELL PURPOSE: Home, Irrigation, Municipal, Industrial, Fish Pond, etc. Poultry Farm		


PUMP DATA		
PUMP TYPE (Circle One): <input checked="" type="radio"/> Submersible Turbine Jet Flowing Well, Other (Describe) _____		
POWER TYPE (Circle One): <input checked="" type="radio"/> Electric Tractor, Diesel, Gasoline, Butane, Other (Describe) _____ H/P 1		
Pump Capacity (GPM) 20	No. of Stages	Setting Depth 80' FT.
PUMP TEST		
Well yielded _____ GPM with a drawdown of _____ ft. after _____ hours of pumping		

WELL DATA		
Well Depth 165'	Casing Diameter (In.) 4"	Casing Length (Ft.) 145'
Type of Casing PVC	Hole Depth 165'	Depth to Static Water Level 48'
TYPE OF COMPLETION: (Circle One or More): <input checked="" type="checkbox"/> Gravel Packed, <input type="checkbox"/> Underreamed, <input type="checkbox"/> Telescoped, <input checked="" type="checkbox"/> Natural Development, <input type="checkbox"/> Open Hole, <input type="checkbox"/> Other (Describe) _____		
Top of Lap Pipe or Reduction in Casing		
FEET IF TELESCOPED OR MORE THAN ONE SCREEN: USE BACK PAGE		

LOG DATA	
TYPE OF LOG RUN (Circle One): Electric, Gamma Ray, Density, Sonic, Neutron, Other (Describe) _____	
<input checked="" type="radio"/> No Log Run	
Name of Organization Running Log	

SCREEN DATA		
Diameter - Inches 4"	Length - Feet 20'	Slot Size - Inches .010
Screen Type PVC	Depth to Bottom - Feet 165'	


GEOLOGIC DATA (Office Use Only)			
Surface Elev.	Geologic Unit	Unit Thickness	Depth to Top
Subs. SWL	Date	Analysis	Aquifer Test
Driller's Remarks			

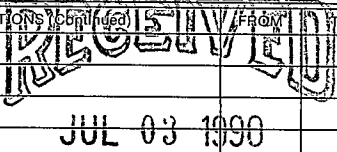DESCRIPTION OF FORMATIONS ENCOUNTERED	FROM	TO	FORMATIONS IDENTIFIED FROM
CLAY	0	14	 JUL 03 1990
SAND	14	18	
CLAY	18	38	
Limestone	38	84	
CLAY	84	142	
SAND	142	165	
IF MORE SPACE IS NEEDED, USE BACK			

**Department of Natural Resources
Bureau of Land & Water Resources**

If well telescopes please
sketch and show depths.

GROUND LEVEL

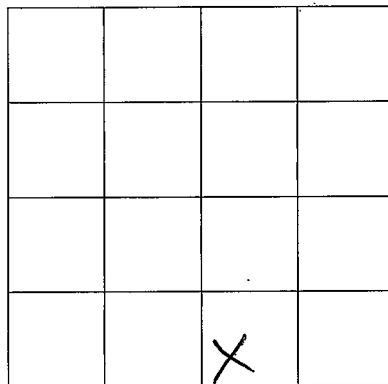

SECTION 23

Please indicate well location X.

ADDITIONAL INFORMATION

If more than one screen,
show location of each on sketch.