

**MISSISSIPPI DEPARTMENT OF ENVIRONMENTAL QUALITY**  
Bureau of Land and Water Resources

P. O. Box 10631  
Jackson, MS 39289-0631  
**WATER WELL DRILLERS LOG**

COUNTY WELL LOCATED <b>SMITH</b>		PERMIT NUMBER
WELL NUMBER <b>R</b>	CODED	NAME OF DRILLING FIRM <b>PARKER WELL SERVICE</b>
DATE WELL COMPLETED <b>2004 6-10-94</b>		

NAME & MAILING ADDRESS OF LANDOWNER  
**DALE WESTBROOKS**  
**RALEIGH MS**

WELL LOCATION: SEC **29** TOWNSHIP **2** RANGE **9S 5W**

DISTANCE **2 1/2** Miles DIRECTION **S** NEAREST TOWN **RALEIGH**

OTHER LANDMARK  
**LIBERTY CHURCH**  
WELL PURPOSE: Home, Irrigation, Municipal, Industrial, Fish Pond, etc.  
**CHICKEN HOUSES**

**PUMP DATA**

PUMP TYPE (Circle One):  
 Submersible Turbine, Jet, Flowing Well, Other (Describe) \_\_\_\_\_

POWER TYPE (Circle One):  
Electric, Tractor, Diesel, Gasoline, Butane, Other (Describe) \_\_\_\_\_  
H/P **1 1/2**

Pump Capacity (GPM) <b>35</b>	No. of Stages <b>12</b>	Setting Depth <b>70</b> FT.
----------------------------------	----------------------------	--------------------------------

PUMP TEST  
Well yielded **35** GPM with a drawdown of **RAN DRAW DOWN SEAL** ft. after \_\_\_\_\_ hours of pumping

**WELL DATA**

Well Depth <b>70'</b>	Casing Diameter (In.) <b>4"</b>	Casing Length (Fl.) <b>50'</b>
Type of Casing <b>PVC</b>	Hole Depth <b>70'</b>	Depth to Static Water Level <b>50'</b>

TYPE OF COMPLETION: (Circle One or More):  
 Gravel Packed,  Underreamed,  Telescoped,  Natural Development,  Open Hole,  Other (Describe) \_\_\_\_\_

Top of Lap Pipe or Reduction in Casing  
FEET \_\_\_\_\_ IF TELESCOPED OR MORE THAN ONE SCREEN: USE BACK PAGE

**LOG DATA**

TYPE OF LOG RUN (Circle One):  
 No Log Run,  Electric,  Gamma Ray,  Density,  Sonic,  Neutron, Other (Describe) \_\_\_\_\_

Name of Organization Running Log \_\_\_\_\_

**SCREEN DATA**

Diameter - Inches <b>4"</b>	Length - Feet <b>20'</b>	Slot Size - Inches <b>006</b>
Screen Type <b>PVC</b>	Depth to Bottom - Feet <b>70'</b>	

**GEOLOGIC DATA (Office Use Only)**

Surface Elev.	Geologic Unit	Unit Thickness	Depth to Top
Subs. SWL	Date	Analysis	Aquifer Test


Driller's Remarks  
**RAN DRAW DOWN SEAL MADE GOOD WELL**

DESCRIPTION OF FORMATIONS ENCOUNTERED	FROM	TO	FORMATIONS (Continued)	FROM	TO
<b>Red CLAY</b>	<b>0</b>	<b>45</b>	<b>RECEIVED</b> <b>JUN 14 1994</b>  Dept. of Environmental Quality Office of Land & Water Resources		
<b>CLAY</b>	<b>45</b>	<b>50</b>			
<b>COARSE SAND</b>	<b>50</b>	<b>70</b>			

IF MORE SPACE IS NEEDED, USE BACK

If well telescopes please sketch and show depths.

GROUND LEVEL

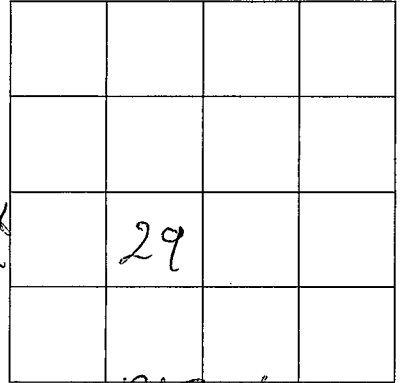

R15W  
SECTION 20

Please indicate well location X.

ADDITIONAL INFORMATION

GO SOUTH ON 35  
TO HOSPITAL  
GO LEFT ON 37  
GO TO 2 DRIVE  
WAY TAKE  
RIGHT HOUSES  
BEHIND HOUSE

If more than one screen,  
show location of each on sketch.