

MISSISSIPPI BOARD OF WATER COMMISSIONERS

SMITH

5 L 4
4-21-62

WATER WELL DRILLERS LOG

Date: April 21, 1962, Driller: W. H. Butler County Smith
(Name)


(1) Owner of Land:	Description & Color of Materials Sand, Clay, Red Clay, Shell, etc.	Thick- ness Feet	Depth Feet
<u>J. H. SCOTT</u> (Name)	<u>Red Clay</u>	<u>1-</u>	<u>15</u>
<u>Subiavana Miss Pt.</u> (Address)	<u>Chalk 1</u>	<u>15-</u>	<u>25</u>
(2) Location: <u>1/4</u> , <u>1/4</u> , Sec. <u>18</u> T <u>24</u> R <u>9</u> E	<u>Blue Chalk</u>	<u>25-</u>	<u>35</u>
<u>6</u> miles <u>East</u> , of <u>Raleigh</u> (distance) (direction) (Nearest Town)	<u>Rock + Lignite</u>	<u>35-</u>	<u>40</u>
(3) Topography: <input checked="" type="checkbox"/> (Hilly) <input type="checkbox"/> (Flat) <input type="checkbox"/> (Level)	<u>Sand</u>	<u>40-</u>	<u>60</u>
(4) Purpose of Well: <u>DOMESTIC</u> (Domestic Irrigation Municipal, Industrial, Other)	<u>Chalk</u>	<u>60-</u>	<u>80</u>
	<u>Sand + Chalk</u>	<u>80-</u>	<u>100</u>
	<u>Sand</u>	<u>100-</u>	<u>110</u>
	<u>Fine Sand</u>	<u>110-</u>	<u>130</u>
	<u>Sand</u>	<u>130-</u>	<u>140</u>

Information upon completion of well:

- (1) Diameter 2" inches.
- (2) Total Depth 110 feet.
- (3) Water Level _____ feet below top of ground.
- (4) Cased to 10.5', Size 2"
- (5) Screen: Size 2", Length 5'
- (6) Were any formations sealed against pollution?
_____ yes, _____ no.

If YES depth of formation _____
Why _____

Drillers Remarks: _____

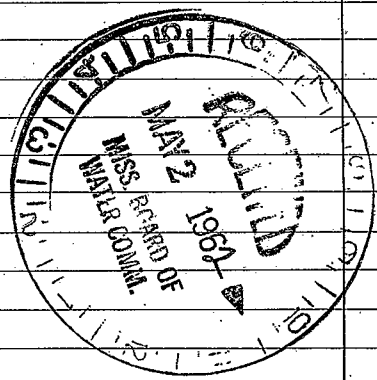

(Use Back Side)

Well No.

