

SMITH

WATER WELL DRILLERS LOG

L 0

Date: Nov 25, 1961, Driller: W. G. Butler County Smith
11-25-61

(Name)

(1) Owner of Land: Middleton

(Name)

Raleigh Miss

(Address)

(2) Location: NE 1/4, NW 1/4, Sec. 9 T2R5EMS8 miles east West of Raleigh

(distance)

(direction)

(Nearest Town)

(3) Topography: (Hilly) (Flat) (Level)(4) Purpose of Well: Domestic(Domestic Irrigation
Municipal, Industrial, Other)

Information upon completion of well:

(1) Diameter 2 inches.(2) Total Depth 50 feet.

(3) Water Level _____ feet below top of ground.

(4) Cased to 42, Size 2'

(5) Screen: Size _____, Length _____.

(6) Were any formations sealed against pollution?

_____ yes, _____ no.


If YES depth of formation _____.

Why _____.

Drillers Remarks: _____.

Description & Color of Materials
Sand, Clay, Red Clay, Shell, etc.Thick-
ness
FeetDepth
Feet

Description & Color of Materials Sand, Clay, Red Clay, Shell, etc.	Thick- ness Feet	Depth Feet
<u>Red clay</u>	<u>1-10</u>	
<u>Chalk</u>	<u>10-15</u>	
<u>Fine sand</u>	<u>15-20</u>	
<u>Sand</u>	<u>20-50</u>	

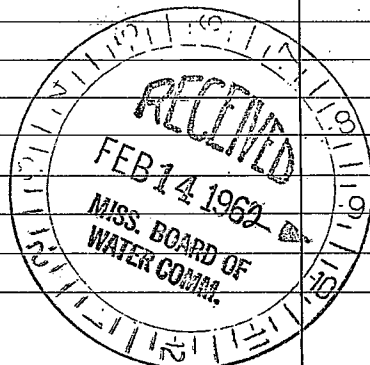

(Use Back Side)

Well No.

Retain this copy for your office files.

