

SMITH

9 L 8

WATER WELL DRILLERS LOG

Date: 1-3-66, 1966, Driller: Brown Brother County SMITH

(Name)

(1) Owner of Land: Loce. A Hancock
(Name)
Box 5 Springs
(Address)

(2) Location: 33 29
1/4, 1/4, Sec. T R
2 mi. N. of Sylva
(distance) (direction) (Nearest Town)

(3) Topography: Flat
(Hilly) (Flat) (Level)

(4) Purpose of Well: Home
(Domestic Irrigation
Municipal, Industrial, Other)

Description & Color of Materials Sand, Clay, Red Clay, Shell, etc.	Thick- ness Feet	Depth Feet
<u>tan clay</u>	<u>20</u>	<u>20</u>
<u>gray shale</u>	<u>20</u>	<u>40</u>
<u>lime shale</u>	<u>20</u>	<u>60</u>
<u>shale</u>	<u>20</u>	<u>80</u>
"	<u>20</u>	<u>100</u>
"	<u>20</u>	<u>120</u>
"	<u>20</u>	<u>140</u>
<u>sand</u>	<u>28</u>	<u>168</u>

Information upon completion of well:

(1) Diameter 4 1/2 inches.

(2) Total Depth 168 feet.

(3) Water Level flowing feet below top of ground.

(4) Cased to 163, Size 2


(5) Screen: Size 5-a, Length 5 ft

(6) Were any formations sealed against pollution?
no yes, no no.

If YES depth of formation _____

Why _____

Drillers Remarks: _____

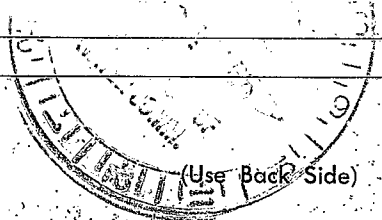

Well No. 1

The first part of the document discusses the importance of maintaining accurate records of all transactions. It emphasizes that every entry should be supported by a valid receipt or invoice. This not only helps in tracking expenses but also ensures compliance with tax regulations.

In the second section, the author provides a detailed breakdown of the monthly budget. It includes categories for housing, utilities, food, and entertainment. Each category is further divided into specific items, such as rent, electricity, groceries, and dining out. This level of detail allows for a clear understanding of where the money is being spent.

The third section focuses on the analysis of the budget. It compares the actual spending against the planned budget for each category. This comparison helps in identifying areas where spending has exceeded the budget and where it has remained within limits. The author notes that while housing and utilities are consistently within budget, there has been a slight increase in dining out expenses.

Finally, the document concludes with a summary of the overall financial performance. It states that the budget was largely adhered to, with only minor deviations. The author expresses a commitment to continuing to monitor spending and make adjustments as needed to stay on track.