

SMITH

L 9 MISSISSIPPI BOARD OF WATER COMMISSIONERS

5-24-66

WATER WELL DRILLERS LOG

Date: 5-24, 1966, Driller: LEACH County: SMITH

(When well drilled)

(Name)

(Where well is located)

(1) Owner of Land: O.V. Herrington
 (Name)
Bay Springs Miss.
 (Address)

(2) Location: 1/4, 1/4, Sec. 23 T 20 R 9E
5 miles West of Bay Springs
 (distance) (direction) (Nearest Town)

(3) Topography: (Hilly) (Flat) (Level)

(4) Purpose of Well: (Domestic Irrigation)
 (Municipal, Industrial, Other)

Description & Color of Materials Sand, Clay, Red Clay, Shell, etc.	Thick- ness Feet	Depth Feet
clay	30	50
rock	20	70
Blue clay	15	85
rock	10	145
Blue clay	22	190
Shell	10	200
sand	41	241

Information upon completion of well:

(1) Diameter 2 inches.


(2) Total Depth 241 feet.

(3) Water Level 60 feet below top of ground.

(4) Cased to 231, Size 2"

(5) Screen: Size 2", Length 10'

(6) Were any formations sealed against pollution?
 yes, no.

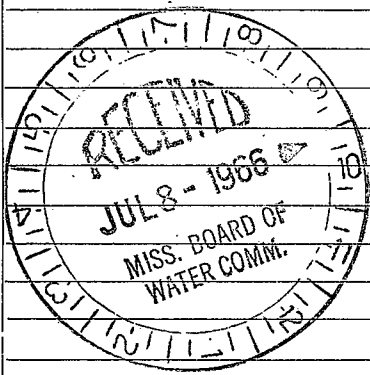

If YES depth of formation _____

Why _____

Drillers Remarks: _____

Yield in gpm: 15

Size pump: 1 1/2 HP

Type power: _____

Total 241

Retain this copy for your office files.

