

SMITH

0

L11 MISSISSIPPI BOARD OF WATER COMMISSIONERS

6-13-66

WATER WELL DRILLERS LOG

Date: 6-13, 1966, Driller: LEACH County: Jasper
(When well drilled) (Name) (Where well is located)

(1) Owner of Land: A DOTT Dykes
(Name)

Bay Springs
(Address)

(2) Location: 1/4, 1/4, Sec. 15 29^W 9^E TR
(distance) (direction) (Nearest Town)

6 miles west of Bay Springs
(distance) (direction) (Nearest Town)

(3) Topography: (Hilly) (Flat) (Level)

(4) Purpose of Well: (Domestic Irrigation) (Municipal, Industrial, Other)

Information upon completion of well:

(1) Diameter: 2 inches.

(2) Total Depth: 41 feet.

(3) Water Level: 20 feet below top of ground.

(4) Cased to: 36, Size: 2"

(5) Screen: Size: 3", Length: 5

(6) Were any formations sealed against pollution?
 yes, no.

If YES depth of formation: _____
Why: _____


Drillers Remarks: _____

Yield in gpm: 10

Size pump: 1/2 HP

Type power: _____

| Description & Color of Materials Sand, Clay, Red Clay, Shell, etc. | Thick- ness Feet | Depth Feet |
|---|------------------------|---------------|
| Red clay | 20 | 20 |
| Sand & gravel | 10 | 30 |
| Sand | 11 | 41 |

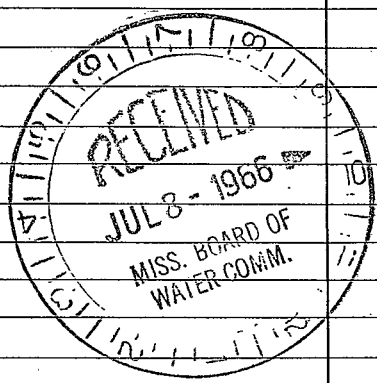

Tate 41

