

CODED

MISSISSIPPI BOARD OF WATER COMMISSIONERS
416 North State Street
Jackson, Mississippi 39201

WATER WELL DRILLERS LOG

Smith
L13
6-69

June 1969 date well completed
Wilkinson Drilling firm name
Smith county well located

LANDOWNER:
Mr. Glenn Hollingworth
BURNS, MRS.
(mailing address)

description of formations encountered	from	to
Small Yellow Clay	0	20
blue & gray	20	110
lime Rock	110	120
Shale & Sand	120	160
Rock & Fine Sand	160	170
SAND	170	185

WELL LOCATION:
sec. 9 T 2 N R 9 E
S W
4 miles E of Raleigh
(distance) (direction) (nearest town)

WELL PURPOSE: HOME
(home, irrigation, municipal, industrial)

WELL COMPLETION DATA:
(1) diameter (inches) 2
(2) total depth (feet) 185
(3) static water level (feet) 126 below above top of ground.
(4) casing Cold, 180,
(material) (depth)
if telescope see back.
(size)
(5) screen 5, 185
(length) (depth to top)
2, Stainless Steel
(size) (material)
(6) pump 1 1/2 7
(HP) (yield gpm)
Elec
(type power)
(7) electric log NO
(yes or no)

(organization running log)
(8) how well bottom plugged 2 B.W.U.

DRILLERS REMARKS:


CODED

JUN 30 1969

MISS. BD. OF WATER COMM.

If well telescopes please
sketch and show depths.

GROUND LEVEL

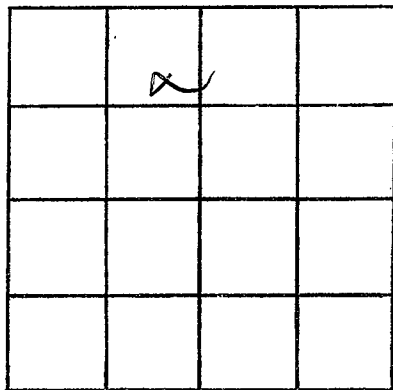

SECTION 9

Please indicate well location X.

ADDITIONAL INFORMATION

If more than one screen,
show locations of each on sketch.