

Smith  
L 14  
5-28-69

MISSISSIPPI  
BOARD OF WATER COMMISSIONERS  
416 North State Street  
Jackson, Mississippi 39201

CODED

WATER WELL DRILLERS LOG

Smith

date well completed MAY 28 1969 Wilkinson Drilling firm name LAKE county well located Smith

LANDOWNER:  
ETTA GRAY  
Raleigh  
(mailing address)

WELL LOCATION:  
sec. 6 T 2 N R 9 E  
S W  
6 miles N of SYLWATER  
(distance) (direction) (nearest town)

WELL PURPOSE: home  
(home, irrigation, municipal, industrial)

WELL COMPLETION DATA:

- (1) diameter (inches) 2
- (2) total depth (feet) 704
- (3) static water level (feet) 170 below above top of ground.
- (4) casing Galv, 700,  
(material) (depth)  
2 if telescope see back.  
(size)
- (5) screen 4, 704  
(length) (depth to top)  
2, Stainless Steel  
(size) (material)
- (6) pump 2, 5 1/2  
(HP) (yield gpm)  
Elcc  
(type power)
- (7) electric log no  
(yes or no)  
(organization running log)
- (8) how well bottom plugged 2" BWC

description of formations encountered	from	to
Red SAND	0	25
brown clay	25	75
Grey clay	75	180
SAND	180	190
blue clay	190	280
Rock + SAND	280	295
blue clay	295	450
blue shale	450	580
brown clay	580	670
Fine SAND	670	698
HARD ROCK	698	699
Good SAND	699	704
Shale	704	730


JUN 30 1969

MISS. DD. 05  
WATER COMM.

DRILLERS REMARKS:

If well telescopes please sketch and show depths.

GROUND LEVEL

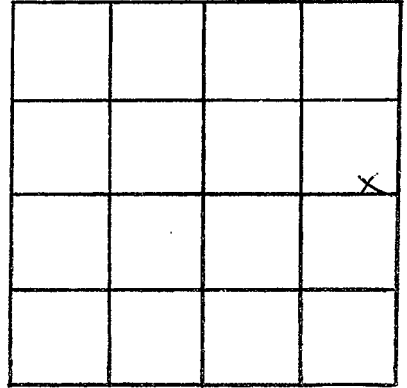

SECTION 6

Please indicate well location X.

ADDITIONAL INFORMATION

If more than one screen,  
show locations of each on sketch.