

CODED

**MISSISSIPPI
BOARD OF WATER COMMISSIONERS**
416 North State Street
Jackson, Mississippi 39201

SMITH
L15
2-4-70

WATER WELL DRILLERS LOG

Feb. 4 19 70 W. G. Butler SMITH
date well completed firm name county well located

LANDOWNER:

Lamar Moss
Raleigh, Miss.
(mailing address)

description of formations encountered

from

to

WELL LOCATION:

sec. 6 T. 2 N. R. 9 E. 4
6 miles E of Raleigh
(distance) (direction) (nearest town)

WELL PURPOSE:

Home
(home) irrigation, municipal, industrial)

WELL COMPLETION DATA:

- (1) diameter (inches) 2"
- (2) total depth (feet) 699
- (3) static water level (feet) 140 below above top of ground.
- (4) casing galv. 672'
(material) (depth)
2" If telescope see back.
(size)
- (5) screen 15 672'
(length) (depth to top)
2" S.S.
(size) (material)
- (6) pump Air Camp 20
(HP) (yield gpm)
Electric
(type power)
- (7) electric log No
(yes or no)
(organization running log)
- (8) how well bottom plugged 2" BWV.

Red-clay + sand	0	10
clay	10	20
clay + rock	20	30
rock	30	50
rock + clay	50	70
clay	70	80
shell, clay, lignite	80	90
sand + clay	90	100
lignite + clay	100	110
clay	110	120
sand + clay	120	130
clay	130	160
clay + sand	160	190
clay	190	210
clay + shell	210	260
clay	260	450
rock + clay	450	490
rock + shell	490	515
rock, shell - clay	515	536
lignite + sand	536	557
clay + sand	557	578
sand clay lignite	578	599
sand + clay	599	641
sand (good)	641	662
sand	662	683
sand + clay	683	699


DRILLERS REMARKS:

FEB 9 - 1970

MISS. Bd. OF WATER COMM.

If well telescopes please sketch and show depths.

GROUND LEVEL

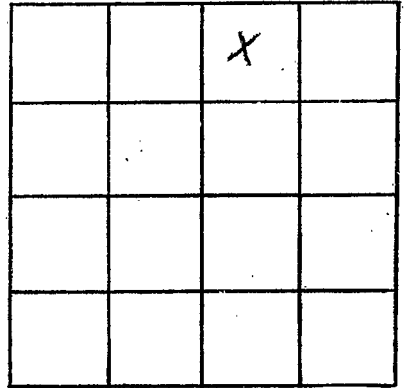

SECTION 6

Please indicate well location X.

ADDITIONAL INFORMATION

If more than one screen,
show locations of each on sketch.