

**Smith**  
**L 16**  
**5-30-70**

MISSISSIPPI  
 BOARD OF WATER COMMISSIONERS  
 416 North State Street  
 Jackson, Mississippi 39201

WATER WELL DRILLERS LOG

5-30 1970 W.K. Barnes & Sons Smith  
 date well completed firm name county well located

LANDOWNER: <u>R: O Thometan</u>	description of formations encountered	from	to
<u>Route 1</u>			
<u>Sylverena miss.</u> (mailing address) <u>073</u>	<u>Red Clay</u>	<u>0</u>	<u>10</u>
	<u>yellow clay</u>	<u>10</u>	<u>23</u>
	<u>Rock</u>	<u>23</u>	<u>25</u>
	<u>Blue Clay</u>	<u>25</u>	<u>44</u>
	<u>Fine Blue Clay</u>	<u>44</u>	<u>54</u>

WELL LOCATION:  
 sec. 17 T. 2 R. 9E  
3 miles West of Sylverena miss.  
 (distance) (direction) (nearest town)

WELL PURPOSE: Home use  
 (home, irrigation, municipal, industrial)

- WELL COMPLETION DATA:
- (1) diameter (inches) 2
  - (2) total depth (feet) 54
  - (3) static water level (feet) 36 below above top of ground.
  - (4) casing Galv. (material) (depth)  
1 1/4 if telescope see back. (size)
  - (5) screen 5 (length) (depth to top)  
80 gauge Stomies S (size) (material)
  - (6) pump Red (HP) 2 (yield gpm)  
Elec (type power)
  - (7) electric log (yes or no)
  - (organization running log)
  - (8) how well bottom plugged Washed


JUN 4 1970

MISS. BD. OF  
 WATER COMM.

DRILLERS REMARKS:

If well telescopes please sketch and show depths.

GROUND LEVEL

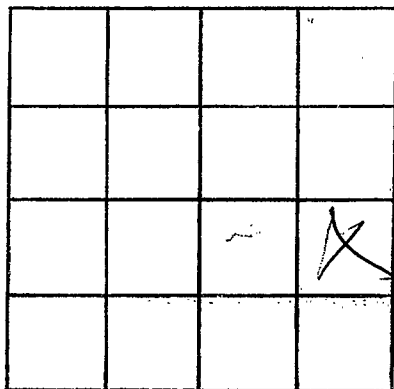

SECTION 17

Please indicate well location X.

ADDITIONAL INFORMATION

If more than one screen,  
show locations of each on sketch.