

SMITH
L17
5-23-72

MISSISSIPPI
 BOARD OF WATER COMMISSIONERS
 416 North State Street
 Jackson, Mississippi 39201

WATER WELL DRILLERS LOG **CODED**

5-23 1972 W.K. Barnes Waterwells Smith
 date well completed firm name county well located

LANDOWNER: D. O. Henry
Sylverana miss.
 (mailing address)

WELL LOCATION:
 sec. 11 T 2 N R 9 E
3 miles N of Sylverna
 (distance) (direction) (nearest town)

WELL PURPOSE: cat fish
 (home, irrigation, municipal, industrial)

- WELL COMPLETION DATA:
- (1) diameter (inches) 4"
 - (2) total depth (feet) 510
 - (3) static water level (feet) 77 below above top of ground.
 - (4) casing Galv. (material) (depth)
 - 2 1/2 if telescope see back. (size)
 - (5) screen 16 ft. (length) (depth to top)
07 (size) Stainless Steel (material)
 - (6) pump 5 (HP) 105 (yield gpm)
Elec. (type power)
 - (7) electric log no (yes or no)
 - (organization running log)
 - (8) how well bottom plugged Lead Sealer

description of formations encountered	from	to
Red Clay	0	4
yellow Clay	4	22
old Brown Clay	22	46
Blue Clay	46	146
Rock	146	151
Blue Clay	151	296
Rock	296	302
Hard Blue Clay	302	361
Rock	361	372
Blue Clay	372	406
Sea Shell	406	460
Fine sand	460	480
Fair water sand	480	510

CODED


AUG 15 1972

MRS. B. OF
 WATER

DRILLERS REMARKS:

If well telescopes please sketch and show depths.

GROUND LEVEL

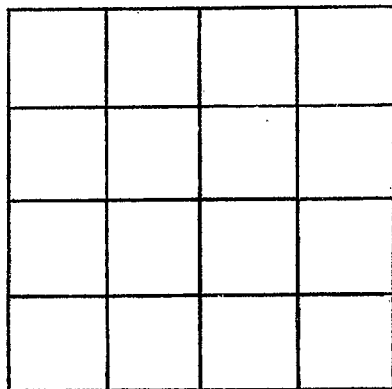

SECTION _____

Please indicate well location X.

ADDITIONAL INFORMATION

If more than one screen,
show locations of each on sketch.