

SMITH
L 18
8-20-73

MISSISSIPPI
BOARD OF WATER COMMISSIONERS
416 North State Street
Jackson, Mississippi 39201

CODED

WATER WELL DRILLERS LOG

8-20 1973 W.K. Barnes Water Well, Smith
date well completed firm name county well located

LANDOWNER Max Wilson
Rt. 1
Bay Springs, Miss.
(mailing address)

description of formations encountered	from	to
<u>yellow sand & clay</u>	<u>0</u>	<u>18</u>
<u>House Sand</u>	<u>18</u>	<u>26</u>
<u>Blue Clay</u>	<u>26</u>	<u>80</u>
<u>Blue Sand</u>	<u>80</u>	<u>95</u>

WELL LOCATION:
sec. 22 T. 2 (N) R. 13 (E)
4 miles West of Bay Springs
(distance) (direction) (nearest town)

WELL PURPOSE:
(home, irrigation, municipal, industrial)

WELL COMPLETION DATA:

(1) diameter (inches) 2

(2) total depth (feet) 95

(3) static water level (feet) 7 below above top of ground.

(4) casing Galv. (material) (depth) _____
2" if telescope see back. (size)

(5) screen 6' (length) (depth to top) _____
06 (size) Stainless S. (material)

(6) pump 1-HP (HP) 15 (yield gpm)
Elec. (type power)

(7) electric log (yes or no) _____
Wash Value (organization running log)

(8) how well bottom plugged _____

CODED


SEP 26 1973

DRILLERS REMARKS:

MISS. Bd. OF
WATER COM.

If well telescopes please sketch and show depths.

GROUND LEVEL

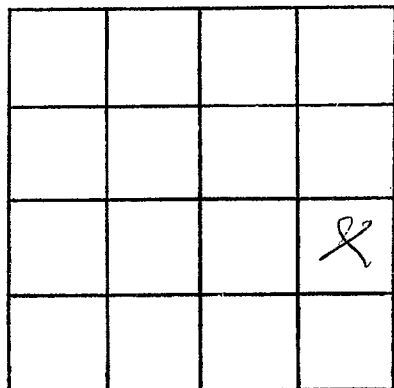

SECTION 92

Please indicate well location X.

ADDITIONAL INFORMATION

If more than one screen,
show locations of each on sketch.