

MISSISSIPPI DEPARTMENT OF NATURAL RESOURCES

Bureau of Land and Water Resources

Southport Mall

P.O. Box 10631

Jackson, Mississippi 39209

WATER WELL DRILLERS LOG

**CODED**

Smith  
L19  
10-23-81

10-23-81

Griner Drilling  
Service, Inc.

Smith

date well completed

firm name

county well located

LANDOWNER:

Supron Energy

(mailing address)

WELL LOCATION: N 18° W 1825' W

sec. 18 T 2 (N) R 9 (E) S 56 (or)

No. 1 East of Sylvaena  
John B. Tillis (direction) of (nearest town)

WELL PURPOSE: oil field supply  
(home, irrigation, municipal, industrial)

WELL COMPLETION DATA:

(1) diameter (inches) 3"

(2) total depth (feet) 714'

(3) static water level (feet) 20' below above top of ground.

(4) casing Steel 567'  
(material) (depth)  
3"  
(size) if telescope see back.

(5) screen 42' 525'  
(length) (depth to top)  
3" perforated  
(size) (material)

(6) pump 80  
(HP) (yield gpm)  
AC  
(type power)

(7) electric log —  
(yes or no)

(organization running log)

(8) how well bottom plugged orange  
peel

DRILLERS REMARKS:

description of formations encountered

from

to

sand

0 63

chalk, rock

63 483

sand

483 567

chalk, rock

567 714

**CODED**

DEPT. OF NATURAL RESOURCES  
BUREAU OF LAND & WATER RESOURCES


OCT 20 1981

RECEIVED

This is West of Sylvaena

If well telescopes please sketch and show depths.

GROUND LEVEL

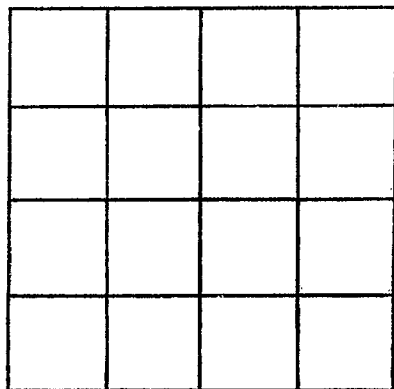

SECTION \_\_\_\_\_

Please indicate well location X.

ADDITIONAL INFORMATION

If more than one screen,  
show locations of each on sketch.