

L21
Smith
08-26-83

MISSISSIPPI
BOARD OF WATER COMMISSIONERS
416 North State Street
Jackson, Mississippi 39201

CODED

WATER WELL DRILLERS LOG

Aug 26 1983 Roy U. West Delg Smith
date well completed firm name county well located

LANDOWNER:	description of formations encountered	from	to
Ed Sims			
Sylvaena MS	CLAY	15	560
(mailing address)	SAND	560	580

WELL LOCATION:
sec. 3 T. 2 N. R. 9 E.
S W
7 miles N of Sylvaena
(distance) (direction) (nearest town)

WELL PURPOSE: POND
(home, irrigation, municipal, industrial)


- WELL COMPLETION DATA:
- (1) diameter (inches) 4"
 - (2) total depth (feet) 580'
 - (3) static water level (feet) 180' below top of ground.
 - (4) casing PVC, 570' (material), (depth)
 - (size) if telescope see back.
 - (5) screen 10' length, 570' depth to top
 - 4" size, 55 material
 - (6) pump 1 1/2 HP, 27 yield gpm
 - REA (type power)
 - (7) electric log no (yes or no)
 - (organization running log)
 - (8) how well bottom plugged WASH VALVE

DRILLERS REMARKS:

DEPT. OF NATURAL RESOURCES
BUREAU OF LAND & WATER RESOURCES
RECEIVED
MAR 16 1984

If well telescopes please sketch and show depths.

GROUND LEVEL

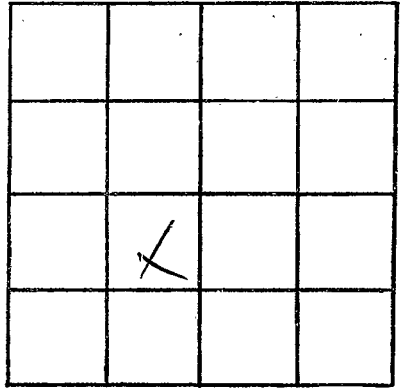

SECTION 3

Please indicate well location X.

ADDITIONAL INFORMATION

If more than one screen,
show locations of each on sketch.