

MISSISSIPPI DEPARTMENT OF NATURAL RESOURCES

Bureau of Land and Water Resources

Southport Mall

P.O. Box 10631

Jackson, Mississippi 39209

WATER WELL DRILLERS LOG

CODED

SMITH <i>OS</i>
L 22
3-15-85

Griner Drilling Service, Inc.

Smith

3-15-85
date well completed

Griner Drilling Service, Inc.
firm name

Smith
county well located

LANDOWNER:	description of formations encountered	from	to
<i>Santa Fe Energy Co. One Security Park 7200 I-40 West Amarillo, Texas 79106</i> (mailing address)			
WELL LOCATION: <i>330' N + 330' E</i> sec. <i>32</i> T. <i>2</i> N. R. <i>9</i> E SW 1/4 <i>No. 1 Lane</i> <i>E. Tallahalla Creek</i> (distance) (direction) (nearest town)	<i>clay, rock, sand</i>	<i>35</i>	<i>588</i>
WELL PURPOSE: <i>oilfield supply</i> (home, irrigation, municipal, industrial)	<i>SAND, breaks clay</i>	<i>588</i>	<i>661</i>
WELL COMPLETION DATA: (1) diameter (inches) <i>3"</i> (2) total depth (feet) <i>672'</i> (3) static water level (feet) <i>10'</i> <input checked="" type="radio"/> below <input type="radio"/> above top of ground. (4) casing <i>steel</i> , <i>65'</i> (material) (depth) <i>3"</i> (size) if telescope see back. (5) screen <i>42'</i> , <i>609'</i> (length) (depth to top) <i>3"</i> , <i>perforated</i> (size) (material) (6) pump <i>-</i> , <i>90</i> (HP) (yield gpm) <i>AC</i> (type power) (7) electric log <input type="checkbox"/> yes <input checked="" type="checkbox"/> no (organization running log) (8) how well bottom plugged <i>orange peel</i>	<i>CLAY</i>	<i>661</i>	<i>672</i>


RECEIVED
MAR 25 1985

Department of Natural Resources
Bureau of Land & Water Resources

DRILLERS REMARKS:

If well telescopes please sketch and show depths.

GROUND LEVEL

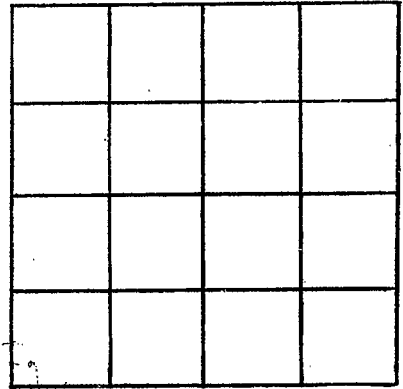

SECTION _____

Please indicate well location X.

ADDITIONAL INFORMATION

If more than one screen, show locations of each on sketch.