

MISSISSIPPI DEPARTMENT OF NATURAL RESOURCES

Bureau of Land and Water Resources

Southport Mall

P.O. Box 10631

Jackson, Mississippi 39209

WATER WELL DRILLERS LOG

CODED

Smith
L 23
5/9/85

5-9-85

Griner Drilling Service, Inc.

Smith

date well completed

firm name

county well located

LANDOWNER:	description of formations encountered	from	to
(mailing address)			
Shell Oil Company P.O. Box 61555 New Orleans 70160	clay, rock, little shell	0	105
	streaked	105	210
WELL LOCATION: 330' N + 1650' E sec. 32 T. 20 N R. 7 E of No. 2 Lane E Tallahala Creek Field (distance) (direction) (nearest town)	clay	210	470
	clay, rock	470	550
WELL PURPOSE: oil field supply (home, irrigation, municipal, industrial)	streaked	550	640
WELL COMPLETION DATA:	sand	640	715
(1) diameter (inches) 3"	clay	715	735
(2) total depth (feet) 735'			
(3) static water level (feet) 10' below top of ground.			
(4) casing steel 714 (material) (depth) 3" (size) if telescope see back.			
(5) screen 42' 672' (length) (depth to top) 3" perforated (size) (material)			
(6) pump - 85 (HP) (yield gpm) AC (type power)			
(7) electric log (yes or no) (organization running log)			
(8) how well bottom plugged orange peel			

RECEIVED


JUN 4 1985

DRILLERS REMARKS:

Department of Natural Resources
Bureau of Land & Water Resources

If well telescopes please sketch and show depths.

GROUND LEVEL

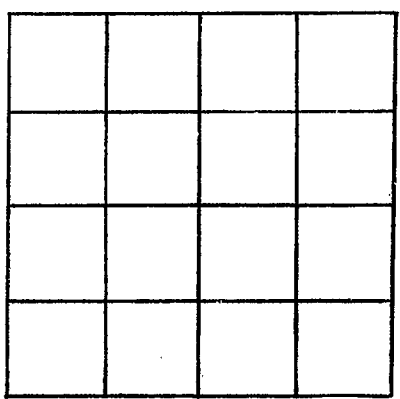

SECTION _____

Please indicate well location X.

ADDITIONAL INFORMATION

A series of horizontal lines for recording additional information, starting below the 'ADDITIONAL INFORMATION' header and extending to the bottom of the page.

If more than one screen, show locations of each on sketch.