

Smith
 6200
 5-11-76

MISSISSIPPI
 BOARD OF WATER COMMISSIONERS
 416 North State Street
 Jackson, Mississippi 39201

13¢

WATER WELL DRILLERS LOG

Smith
 Jasper

May 11 1976 date well completed
 Roy West water wells firm name
 Jasper county well located

LANDOWNER	description of formations encountered	from	to
W.D. Posey Rt 2	Sandy Clay	0	15
Bay Springs (mailing address)	Blue Clay	15	130
	sand	130	158

WELL LOCATION:
 sec. 19 T. 2 N. R. 9 E.
 S W
 1/2 miles SW of Dylmar
 (distance) (direction) (nearest town)

WELL PURPOSE: Home
 (home, irrigation, municipal, industrial)

- WELL COMPLETION DATA:
- (1) diameter (inches) 2
 - (2) total depth (feet) 153
 - (3) static water level (feet) 100 below top of ground.
 - (4) casing galv 153
 (material) (depth)
 (size) if telescope see back.
 - (5) screen 5 153
 (length) (depth to top)
1 1/4 in St Steel
 (size) (material)
 - (6) pump 1 5
 (HP) (yield gpm)
REA
 (type power)
 - (7) electric log NO
 (yes or no)

(organization running log)
 (8) how well bottom plugged wash water


DRILLERS REMARKS:

RECEIVED

JUL 15 1976

If well telescopes please sketch and show depths.

GROUND LEVEL

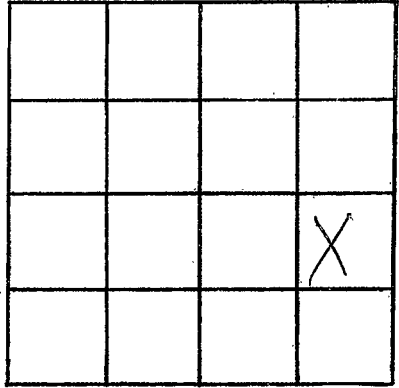

SECTION 19

Please indicate well location X.

ADDITIONAL INFORMATION

If more than one screen,
show locations of each on sketch.