

**MISSISSIPPI
BOARD OF WATER COMMISSIONERS**
416 North State Street
Jackson, Mississippi 39201

WATER WELL DRILLERS LOG

SMITH
L
2001

4-20 1984 ROY V. WEST DRG SMITH
date well completed firm name county well located

LANDOWNER:	description of formations encountered	from	to
<u>MAX Wilson</u>	<u>SANDY TOPSOIL</u>	<u>0</u>	<u>2</u>
(mailing address)	<u>CLAY</u>	<u>2</u>	<u>10</u>
WELL LOCATION:	<u>SAND</u>	<u>10</u>	<u>14</u>
sec. <u>26 T 2 N</u> R. <u>9 E</u>	<u>CLAY</u>	<u>14</u>	<u>28</u>
<u>4</u> miles <u>SE</u> of <u>SYLVAN</u>	<u>SAND</u>	<u>28</u>	<u>32</u>
(distance) (direction) (nearest town)	<u>CLAY</u>	<u>32</u>	<u>36</u>
WELL PURPOSE:	<u>SAND</u>	<u>36</u>	<u>46</u>
(home, irrigation, municipal, industrial)			
WELL COMPLETION DATA:			
(1) diameter (inches) <u>2"</u>			
(2) total depth (feet) <u>46'</u>			
(3) static water level (feet) <u>12'</u> <u>below</u> top of ground.			
(4) casing <u>PVC</u> <u>41'</u>			
(material) (depth)			
<u>2"</u> If telescope see back.			
(size)			
(5) screen <u>5'</u> <u>41'</u>			
(length) (depth to top)			
<u>1/4"</u> <u>STAINLESS</u>			
(size) (material)			
(6) pump <u>1</u> <u>6</u>			
(HP) (yield gpm)			
<u>REA</u>			
(type power)			
(7) electric log <u>no</u>			
(yes or no)			
(organization running log)			
(8) how well bottom plugged			
<u>WASH VALVE</u>			
DRILLERS REMARKS:			


DEPT. OF NATURAL RESOURCES
BUREAU OF LAND & WATER RESOURCES

MAY - 4 1984

RECEIVED

If well telescopes please sketch and show depths.

GROUND LEVEL

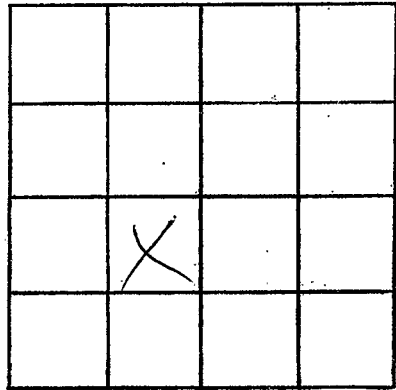

SECTION 26

Please indicate well location X.

ADDITIONAL INFORMATION

If more than one screen, show locations of each on sketch.