

MISSISSIPPI DEPARTMENT OF NATURAL RESOURCES

Bureau of Land and Water Resources

Southport Mall

P.O. Box 10631

Jackson, Mississippi 39209

WATER WELL DRILLERS LOG

SMITH  
L 2000

9-19  
date well completed

1986 Roy K. West  
firm name

Smith  
Jasper  
county well located

LANDOWNER:  
JACK WHITE  
BAY SPRINGS  
(mailing address)


description of formations encountered	from	to
CLAY	0	2
SAND	2	23
CLAY	23	148
SANDY STRS	148	157
SAND	157	166
CLAY	166	170
SAND	170	180

WELL LOCATION:  
sec. 25 T 2 N R 9 E  
S W  
4 miles W of Bay Springs  
(distance) (direction) (nearest town)

WELL PURPOSE:  
(home, irrigation, municipal, industrial)

WELL COMPLETION DATA:

- (1) diameter (inches) 4"
- (2) total depth (feet) 180'
- (3) static water level (feet) 106' below top of ground.
- (4) casing PVC, 157' (material) (depth)
- (size) If telescope see back.
- (5) screen 20' 157' (length) (depth to top)
- (size) (material)
- (6) pump 3/4 12 (HP) (yield gpm)
- REA (type power)
- (7) electric log no (yes or no)
- (organization running log)
- (8) how well bottom plugged WASH VALVE

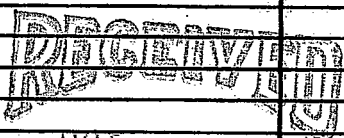


DEC 09 1985

Department of Natural Resources  
Bureau of Land & Water Resources

DRILLERS REMARKS:

If well telescopes please sketch and show depths.

GROUND LEVEL

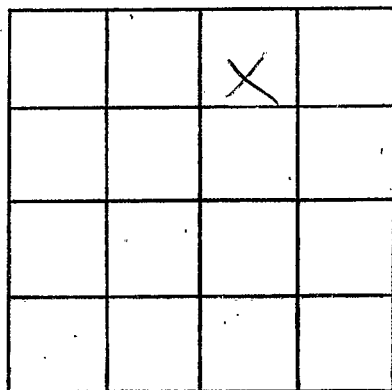

SECTION 25

Please indicate well location X.

ADDITIONAL INFORMATION

If more than one screen,  
show locations of each on sketch.